

Harrison
 F-180
 12-4-79

MISSISSIPPI
 BOARD OF WATER COMMISSIONERS
 416 North State Street
 Jackson, Mississippi 39201

CODED

WATER WELL DRILLERS LOG

12-4 date well completed 1979 Braden Pump Well firm name Harrison county well located Service, Inc

LANDOWNER: Bill Seefelt
 Rt. 2, Box 290
 Gulfport, MS 39503
 (mailing address)

WELL LOCATION:
 sec. 30 T. 6 S. R. 12 W
 3 miles S of Lizana
 (distance) (direction) (nearest town)

WELL PURPOSE: HOME
 (home, irrigation, municipal, industrial)

WELL COMPLETION DATA:
 (1) diameter (inches) 4"x2"
 (2) total depth (feet) 710'
 (3) static water level (feet) 61' below top of ground.
 (4) casing PVC total
 (material) (depth)
 2"x4" If telescope see back.
 (size)
 (5) screen 10' 700'
 (length) (depth to top)
 2" 208 PVC underdrain
 (size) (material)
 (6) pump 1 sub 20
 (HP) (yield gpm)
 220 KIP
 (type power)
 (7) electric log no
 (yes or no)
 (organization running log)
 (8) how well bottom plugged
 2" sand shank

description of formations encountered	from	to
Clay	0	40
Sand	40	60
Clay	60	300
Sand	300	340
Clay	340	420
Sand	420	480
Clay	480	620
Sand	620	710

CODED

DEPT. OF NATURAL RESOURCES
 BUREAU OF LAND & WATER RESOURCES


JAN 19 1980

RECEIVED

DRILLERS REMARKS:
 No tail pipe

If well telescopes please sketch and show depths.

GROUND LEVEL

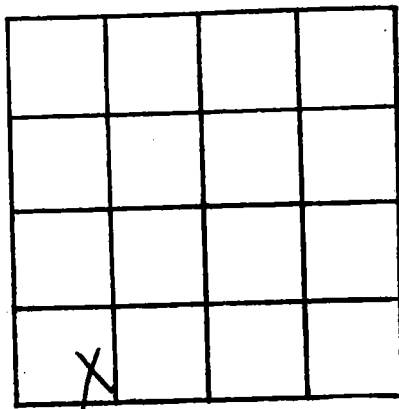

SECTION 30

Please indicate well location X.

ADDITIONAL INFORMATION

If more than one screen, show locations of each on sketch.