

MISSISSIPPI DEPARTMENT OF NATURAL RESOURCES

Bureau of Land and Water Resources

Southport Mall

P.O. Box 10631

Jackson, Mississippi 39209

WATER WELL DRILLERS LOG

CODED

Harrison
F182
4-6-81

4/6/81 19 Lyman Well Co. Harrison
date well completed firm name county well located

LANDOWNER: Bob Mandal
Gulf Haven Rd
Southport,
(mailing address)


description of formations encountered	from	to
yellow/red clay	0	9
white/pink sand & gravel	9	44
gray/blue clay	44	160
fair sand	160	195
blue clay	195	513
fine sand	513	538
blue clay	538	680
good sand	680	753

WELL LOCATION:
sec. 32 T. 6 N. R. 12 E.
8 miles (distance) W of Long Beach (nearest town)

WELL PURPOSE: home
(home, irrigation, municipal, industrial)


- WELL COMPLETION DATA:
- (1) diameter (Inches) 4x2
 - (2) total depth (feet) 753'
 - (3) static water level (feet) 90 below top of ground.
 - (4) casing PVC (material), 723' (depth)
4x2 if telescope see back. (size)
 - (5) screen 30' (length), 723' (depth to top)
2" (size), PVC (material)
 - (6) pump 1 1/2 (HP), 25 (yield gpm)
electric (type power)
 - (7) electric log No (yes or no)
No (organization running log)
 - (8) how well bottom plugged sand
shark

DRILLERS REMARKS: _____

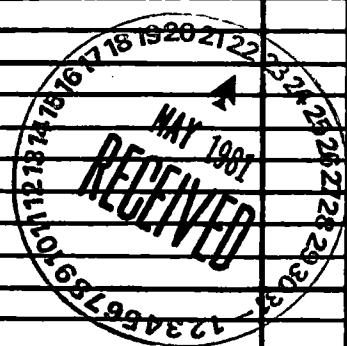

if well telescopes please sketch and show depths.

GROUND LEVEL

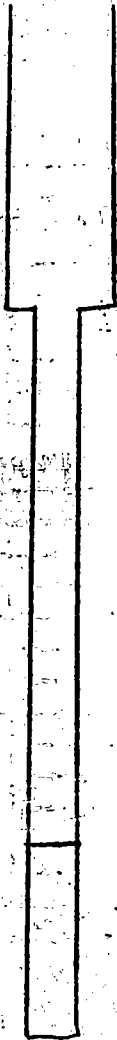

200'
4" PVC

523'
2" PVC

30'
2" SCREEN

	↑		

SECTION _____

Please indicate well location X.

ADDITIONAL INFORMATION

If more than one screen, show locations of each on sketch.