

MISSISSIPPI DEPARTMENT OF NATURAL RESOURCES

Bureau of Land and Water Resources

Southport Mall

P.O. Box 10631

Jackson, Mississippi 39209

WATER WELL DRILLERS LOG

HARRISON
F 183
7/26/82

7/26 1982 Hyman Well Co Harrison
 date well completed firm name county well located

LANDOWNER Tolson Barry
 Hwy 53
 Gulfport, MS 39503
 (mailing address)

description of formations encountered	from	to
Red Sand White Clay	0	110
fine Sand	110	240
Gumbo Mud		
Red Sand	240	320
wood		
Blue & Gray Gumbo Mud	320	460
Good Sand	460	516

WELL LOCATION:
 sec 24 T. 6 N. R. 12 E.
12 miles N/W of Gpt.
 (distance) (direction) (nearest town)

WELL PURPOSE: Home
 (home, irrigation, municipal, industrial)

WELL COMPLETION DATA:
 (1) diameter (inches) 4x2
 (2) total depth (feet) 516
 (3) static water level (feet) 104 below above top of ground.
 (4) casing PVC, 496,
 (material) (depth)
4x2 if telescope see back.
 (size)
 (5) screen 20', 516
 (length) (depth to top)
2", PVC
 (size) (material)
 (6) pump 1/2 34
 (HP) (yield gpm)
Elect.
 (type power)
 (7) electric log NO
 (yes or no)
NO
 (organization running log)
 (8) how well bottom plugged Sand
Shank

CODED

DEPT. OF NATURAL RESOURCES
 BUREAU OF LAND & WATER RESOURCES

FEB 28 1983


RECEIVED

DRILLERS REMARKS:

If well telescopes please sketch and show depths.

2817

GROUND LEVEL

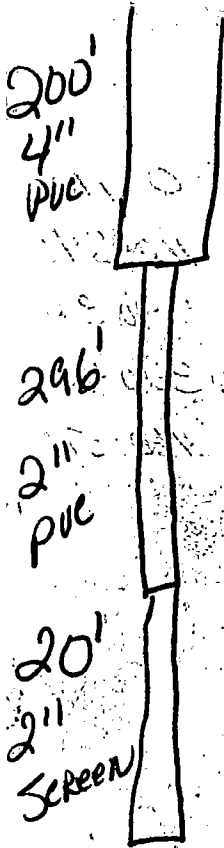

	X		

SECTION 24

Please indicate well location X.

ADDITIONAL INFORMATION

If more than one screen, show locations of each on sketch.