

MISSISSIPPI DEPARTMENT OF NATURAL RESOURCES

Bureau of Land and Water Resources

Southport Mall

P.O. Box 10631

Jackson, Mississippi 39209

WATER WELL DRILLERS LOG

CODED

F 184
 HARRISON
 6-25-31-83

5/31 1983 Lymex Well Co. Harrison
 date well completed firm name county well located

LANDOWNER: Jeff Ware
Ahaumbacher Rd
Gulfport MS 39503
 (mailing address)

WELL LOCATION:
 sec 20 T 6 N R 12
12 miles NW of Hot.
 (distance) (direction) (nearest town)

WELL PURPOSE: Home
 (home, irrigation, municipal, industrial)

WELL COMPLETION DATA:
 (1) diameter (inches) 4x2"
 (2) total depth (feet) 538
 (3) static water level (feet) 68' below above top of ground.
 (4) casing PVC 518
 (material) (depth)
4x2 if telescope see back.
 (size)
 (5) screen 20' 538
 (length) (depth to top)
2" PVC
 (size) (material)
 (6) pump 1 34
 (HP) (yield gpm)
Elect.
 (type power)
 (7) electric log NO
 (yes or no)
NO
 (organization running log) Sand Shark
 (8) how well bottom plugged

description of formations encountered	from	to
Red Sand & White Clay	0	70
Blue Gumbo Clay	70	150
Hard Grey & Blue Clay	150	280
Red Sand	280	340
Blue Clay	340	420
Pine Sand & Clay	420	480
Gravel sand	480	538

CODED

DEPT. OF NATURAL RESOURCES
 BUREAU OF LAND & WATER RESOURCES

NOV - 3 1983

RECEIVED


DRILLERS REMARKS: _____

If well telescopes please sketch and show depths.

GROUND LEVEL

Well No. 1

Red Sand 4'
 3 1/2" Clay 10'
 Blue Gravel 10'
 Hard Gravel 10'
 Clay 10'
 Red Clay 10'
 Red Clay 10'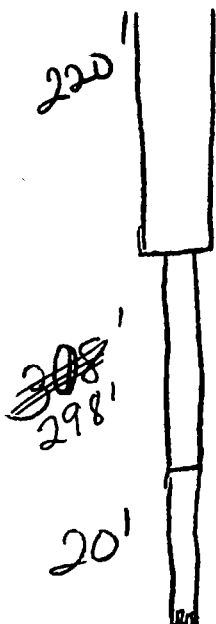
If more than one screen, show locations of each on sketch.

2/31
 2/31
 2/31

SECTION _____

Please indicate well location X.

ADDITIONAL INFORMATION

4x7
 38
 28
 218
 4x7
 30' 238
 4" 4V
 34
 1
 310
 310
 200
 200