

MISSISSIPPI DEPARTMENT OF NATURAL RESOURCES

Bureau of Land and Water Resources

Southport Mall

P.O. Box 10631

Jackson, Mississippi 39209

WATER WELL DRILLERS LOG

**CODED**

HARRISON
F185
1/25/84

1-25-84  
date well completed

Mc Gill Well Works  
firm name

Harrison  
county well located

LANDOWNER: Don Mujil  
E. LADNER, RD  
Saucier, Miss.  
(mailing address)

description of formations encountered	from	to
med	0	220
med-sand	220	280
f. sand	280	290
coarse sand	290	300

WELL LOCATION:  
sec. 1 T. 6 N. R. 12 E.  
5 miles S of SAUCIER  
(distance) (direction) (nearest town)

WELL PURPOSE: Home  
(home, irrigation, municipal, industrial)

- WELL COMPLETION DATA:
- (1) diameter (inches) 2"
  - (2) total depth (feet) 300'
  - (3) static water level (feet) 90' below above top of ground.
  - (4) casing Sch. 40 PVC  
(material) (depth)
  - (size) If telescope see back.
  - (5) screen 10' (length) (depth to top)  
2" (size) Sch. 80 PVC (material)
  - (6) pump caprid (HP) (yield gpm)  
1/2 (type power)
  - (7) electric log (yes or no)
  - (organization running log)
  - (8) how well bottom plugged Sand Seal

**CODED**

DEPT. OF NATURAL RESOURCES  
BUREAU OF LAND & WATER RESOURCES


FEB - 3 1984

**RECEIVED**

DRILLERS REMARKS:

If well telescopes please sketch and show depths.

GROUND LEVEL

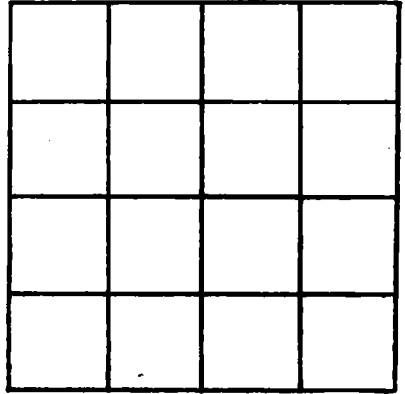

SECTION \_\_\_\_\_

Please indicate well location X.

ADDITIONAL INFORMATION

If more than one screen, show locations of each on sketch.