

F-25 186

5-15-62

WATER WELL DRILLERS LOG

CODED

F-305

Date: 5-15, 1962, Driller: Sutter Well Works County Harrison

(Name)

(1) Owner of Land: Helen Ladner (Name)

Rt. 2 Hgt. (Address)

(2) Location: SW 1/4, SW 1/4, Sec. 14 T6S R12 W 14 miles N of Pass Christian (distance) (direction) (Nearest Town)

(3) Topography: hilly (Hilly) (Flat) (Level)

(4) Purpose of Well: domestic (Domestic Irrigation Municipal, Industrial, Other)

Description & Color of Materials Sand, Clay, Red Clay, Shell, etc.	Thick- ness Feet	Depth Feet
red sand	60	60
clay	221	281
stud	40	321
CODED		
CODED		


Information upon completion of well:

- (1) Diameter 2 inches.
- (2) Total Depth 321 feet.
- (3) Water Level 88 feet below top of ground.
- (4) Cased to all, Size 2"
- (5) Screen: Size 2", Length 5'
- (6) Were any formations sealed against pollution?
yes, no.

If YES depth of formation

Why

Drillers Remarks:

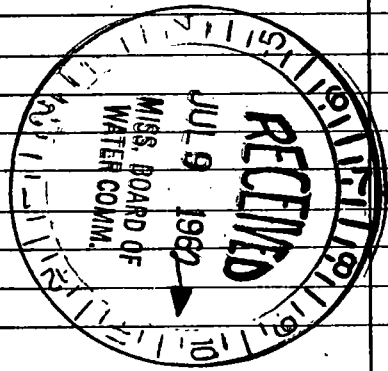

(Use Back Side)

Well No.

[Faint, mostly illegible handwritten text on a grid background. The text is scattered across the page and includes various words and phrases that are difficult to decipher due to the quality of the scan and the handwriting.]