

McDonnell Road 1 1/2 miles from County Farm Road

Harrison
7-50187
1-68

MISSISSIPPI
BOARD OF WATER COMMISSIONERS
416 North State Street
Jackson, Mississippi 39201

CODED
CODED

WATER WELL DRILLERS LOG

1-29 1968 Switzer Shell Co. Harrison
date well completed firm name county well located

LANDOWNER: James Taylor
Route 3 Box 515
Melpop, Miss.
(mailing address)


WELL LOCATION:
sec. 22 T. 6 N R. 12 E
S W
2.8 miles W of LYMAN
(distance) (direction) (nearest town)

WELL PURPOSE: Home
(home, irrigation, municipal, industrial)

WELL COMPLETION DATA:

- (1) diameter (inches) 2
- (2) total depth (feet) 594
- (3) static water level (feet) 68 below top of ground.
- (4) casing gal. steel 584' (material) (depth)
1" if telescope see back. (size)
- (5) screen 0' 584' (length) (depth to top)
8 ga. ss on pipe (size) (material)
- (6) pump 1 450 GPM (HP) (yield gpm) 89 GPM
electric (type power)
- (7) electric log Yes (yes or no)
(organization running log)
- (8) how well bottom plugged Back pressure valve

description of formations encountered	from	to
clay	0	12
sand	12	34
clay	34	43
mixed	43	64
clay	64	94
fine sand	94	104
sand	104	116
fine clay	116	124
clay	124	144
mixed	144	165
good red. sand	165	186
good sand	186	194
good clay	194	207
clay	207	228
mixed	228	249
clay	249	270
mixed	270	309
clay	309	325
sand	325	336
clay	336	349
mixed	349	370
fine sand	370	391
sand	391	393
mixed	393	433
clay	433	454
mixed	454	515
clay + shell	515	557
good sand	557	599

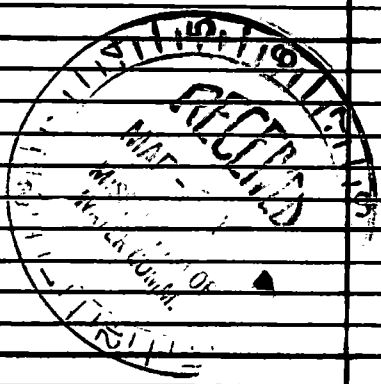

DRILLERS REMARKS:

If well telescopes please sketch and show depths.

GROUND LEVEL

X			

SECTION 22

Please indicate well location X.

ADDITIONAL INFORMATION

If more than one screen, show locations of each on sketch.