

MISSISSIPPI DEPARTMENT OF NATURAL RESOURCES

Bureau of Land and Water Resources

Southport Mall

P.O. Box 10631

CODED

Jackson, Mississippi 39209

WATER WELL DRILLERS LOG  
COASTAL DRILLING & SERVICE CO.

ROUTE 1 BOX 618

county well located

BILOXI, MISS. 39532

description of formations encountered

from to

LANDOWNER

*John Jones*  
*Shaw Road Rt 6*

<i>top soil</i>	<i>1</i>	<i>4</i>
<i>Red Clay</i>	<i>4</i>	<i>30</i>
<i>white sand</i>	<i>30</i>	<i>60</i>
<i>Soft Blue Clay</i>	<i>60</i>	<i>210</i>
<i>fine white sand</i>	<i>210</i>	<i>240</i>
<i>hard blue clay</i>	<i>240</i>	<i>570</i>
<i>fine white sand</i>	<i>570</i>	<i>590</i>
<i>good water sand</i>	<i>590</i>	<i>635</i>

*John Jones*

(mailing address)

WELL LOCATION:

sec *10* T *6* N R *12* E  
S W  
*Little Biloxi River*  
(distance) (direction) (nearest town)

WELL PURPOSE: *home*  
(home, irrigation, municipal, industrial)

WELL COMPLETION DATA:

- (1) diameter (inches) *4 1/2"*
- (2) total depth (feet) *635'*
- (3) static water level (feet) *70'* below top of ground.
- (4) casing *PVC*, *6020'*  
(material) (depth)  
*4 1/2"* if telescope see back.  
(size)
- (5) screen *15'*, *6020'*  
(length) (depth to top)
- 2"*  
(size) *PVC*  
(material)
- (6) pump *1 1/2* *24*  
(HP) (yield gpm)
- 3hp*  
(type power)
- (7) electric log *no*  
(yes or no)

CODED

(organization running log)

DEPT. OF NATURAL RESOURCES  
BUREAU OF LAND & WATER RESOURCES

AUG 15 1983

RECEIVED

(8) how well bottom plugged  
*2 1/2" backwash valve*  
DRILLERS REMARKS: *19-B*

**F183**  
**HARRISON**  
**2-2-83**

188

*2/2/83*  
date well completed

*Harrison*

If well telescopes please sketch and show depths.

GROUND LEVEL

200' 4" PVC Casing



420' - 2" PVC Casing




15' 2" PVC Screen

2" back Wash Valve

19-13

If more than one screen, show locations of each on sketch.

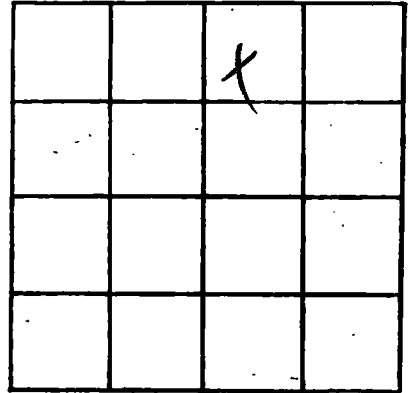

SECTION \_\_\_\_\_

Please indicate well location X.

ADDITIONAL INFORMATION

Multiple horizontal lines for providing additional information.