

L F-191 U 413507  
2-9-62

WATER WELL DRILLERS LOG

CODED (?)

Date: Feb 9, 1962, Driller: C. I. SWITZER WELL CO. County Harrison

(Name)

(1) Owner of Land: K. D. Sanders  
(Name)  
Rt. 1, Box 408B Gulfport, Miss  
(Address)

(2) Location: 1/4, 3 1/4 Sec. 6 F 2  
(distance) (direction) (Nearest Town)

(3) Topography: X  
(Hilly) (Flat) (Level)

(4) Purpose of Well: Domestic  
(Domestic Irrigation  
Municipal, Industrial, Other)

Description & Color of Materials Sand, Clay, Red Clay, Shell, etc.	Thick- ness Feet	Depth Feet
Clay	00	20
Sand, good	20	60
Clay	60	95
Sand	95	100
Sand, fine	100	104
Clay	104	140
Sand, fine	140	160
Sand, good	160	180

Information upon completion of well:

(1) Diameter 2 inches.

(2) Total Depth 180 feet.

(3) Water Level 1' feet below top of ground.

(4) Cased to 180', Size 2"


(5) Screen: Size 2", Length 10'

(6) Were any formations sealed against pollution?  
X yes,        no.

If YES depth of formation \_\_\_\_\_  
Why Health Dept. Requirement

Drillers Remarks: \_\_\_\_\_

CODED

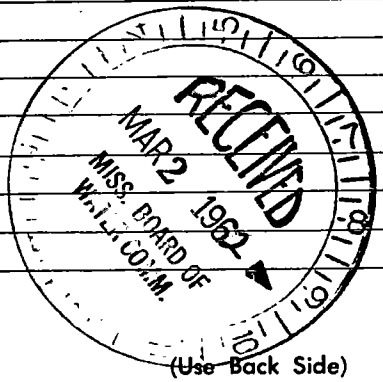

Well No.

