

MISSISSIPPI DEPARTMENT OF NATURAL RESOURCES

Bureau of Land and Water Resources

Southport Mall

P.O. Box 10631

Jackson, Mississippi 39209

WATER WELL DRILLERS LOG

CODED

Harrison
F 195

date well completed 1-14-83 firm name McMill Wells, Inc. county well located Harrison

LANDOWNER: <u>J. J. Maynard</u> <u>Vidalia Road</u>	description of formations encountered	from	to
<u>Pass Christian, Ms</u> (mailing address)	<u>mud</u>	<u>0</u>	<u>20</u>
WELL LOCATION:	<u>sand</u>	<u>20</u>	<u>60</u>
sec. <u>8</u> T <u>6</u> N R <u>12</u> E <u>5</u> miles <u>S.W.</u> of <u>Delisle</u> (distance) (direction) (nearest town)	<u>mud</u>	<u>60</u>	<u>500</u>
WELL PURPOSE: <u>home</u> (home, irrigation, municipal, industrial)	<u>sand</u>	<u>500</u>	<u>560</u>
WELL COMPLETION DATA:			
(1) diameter (inches) <u>2"</u>			
(2) total depth (feet) <u>560'</u>			
(3) static water level (feet) <u>100'</u> ^{below} _{above} top of ground.			
(4) casing <u>Sch 40 PVC</u> <u>350'</u> (material) (depth)			
<u>2"</u> (size) if telescope see back.			
(5) screen <u>10'</u> (length) (depth to top)			
<u>2"</u> <u>sch. 80 PVC</u> (size) (material)			
(6) pump <u>1</u> <u>5</u> (HP) (yield gpm)			
<u>electric</u> (type power)			
(7) electric log _____ (yes or no)			
(organization running log)			
(8) how well bottom plugged <u>sand</u> <u>seal</u>			
DRILLERS REMARKS:			


DEPT. OF NATURAL RESOURCES
BUREAU OF LAND & WATER RESOURCES

AUG 10 1983

RECEIVED

If well telescopes please sketch and show depths.

GROUND LEVEL

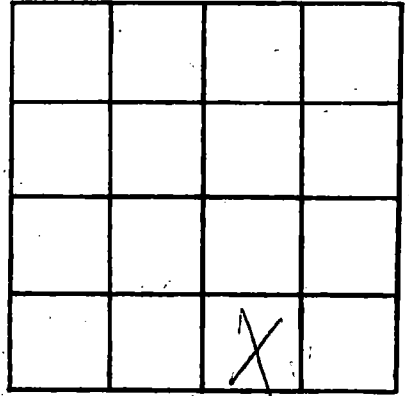

SECTION 8

Please indicate well location X.

ADDITIONAL INFORMATION

If more than one screen, show locations of each on sketch.