

MISSISSIPPI DEPARTMENT OF NATURAL RESOURCES

Bureau of Land and Water Resources

Southport Mall

P.O. Box 10631

Jackson, Mississippi 39209

WATER WELL DRILLERS LOG

Hans
F197

CODED

CODED

5/16/83 19 Lyman Well Harrison
 date well completed firm name county well located

LANDOWNER: Mr. Giles
Rt. 1, Box 166
Gulfport 39503
 (mailing address)

description of formations encountered	from	to
<u>Red sand Gravel</u>	<u>0</u>	<u>120</u>
<u>Blue Gumbo mud</u>	<u>120</u>	<u>194</u>
<u>Good sand</u>	<u>194</u>	<u>225</u>

WELL LOCATION:
 sec. 13 T. 6 N. R. 12 E.
9 miles S of Get.
 (distance) (direction) (nearest town)

WELL PURPOSE: home
 (home, irrigation, municipal, industrial)

WELL COMPLETION DATA:

(1) diameter (inches) 2"

(2) total depth (feet) 225'

(3) static water level (feet) 20' below above top of ground.

(4) casing PVC, 215'
 (material) (depth)
2" If telescope see back.
 (size)

(5) screen 10', 215'
 (length) (depth to top)
2", PVC
 (size) (material)

(6) pump 1 15
 (HP) (yield gpm)
Elect
 (type power)

(7) electric log NO
 (yes or no)
NO
 (organization running log)

(8) how well bottom plugged sand
shark

DRILLERS REMARKS: NO


DEPT. OF NATURAL RESOURCES
 BUREAU OF LAND & WATER RESOURCES

AUG 29 1983

RECEIVED

If well telescopes please sketch and show depths.

GROUND LEVEL

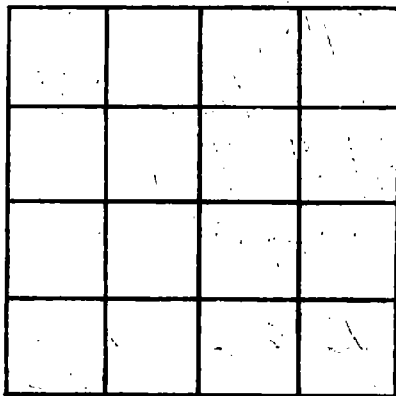

SECTION _____

Please indicate well location X.

ADDITIONAL INFORMATION

If more than one screen, show locations of each on sketch.