

HARRISON
F 199
7-26-75

MISSISSIPPI
 BOARD OF WATER COMMISSIONERS
 416 North State Street
 Jackson, Mississippi 39201

CODED

WATER WELL DRILLERS LOG

date well completed 7/26 19 75 COASTAL DRILLING & SERVICE CO. Mississippi
 well name ROUTE 7 BOX 618 county well located

LANDOWNER Homer Smith P.O. Box 39532

description of formations encountered	from	to
<u>Top Soil</u>	<u>1</u>	<u>3</u>
<u>Red Clay</u>	<u>3</u>	<u>6</u>
<u>Sand (Red)</u>	<u>6</u>	<u>12</u>
<u>White Sand</u>	<u>12</u>	<u>30</u>
<u>Shale</u>	<u>30</u>	<u>40</u>
<u>Soft Blue Clay</u>	<u>40</u>	<u>220</u>
<u>Hard Blue</u>	<u>220</u>	<u>460</u>
<u>Coarse white sand</u>	<u>460</u>	<u>525</u>

John Clark Rd
Sgt. Miss
 (mailing address)

WELL LOCATION:
 sec 25 T 14 N R 12 E
 S W
2 1/2 miles W Lynn
 (distance) (direction) (nearest town)

WELL PURPOSE: home
 (home, irrigation, municipal, industrial)

WELL COMPLETION DATA:


- (1) diameter (inches) 2"
- (2) total depth (feet) 525'
- (3) static water level (feet) 40 below above top of ground.
- (4) casing PVC, 515'
 (material) (depth)
 (size) If telescope see back.
- (5) screen 10', 515'
 (length) (depth to top)
2", PVC
 (size) (material)
- (6) pump one, 15
 (HP) (yield gpm)
Ele
 (type power)
- (7) electric log no
 (yes or no)
 (organization running log)

(8) how well bottom plugged
2 1/2 inch mesh valve
 DRILLERS REMARKS:
none

RECEIVED
 MAR 17 1976

If well telescopes please sketch and show depths.

GROUND LEVEL

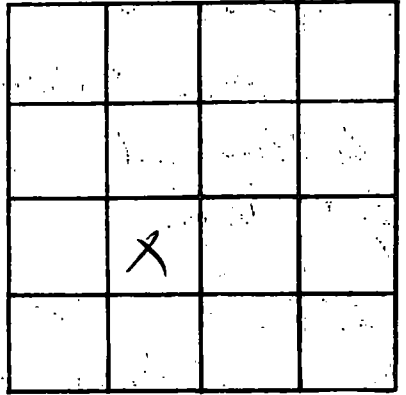

SECTION _____

Please indicate well location X.

ADDITIONAL INFORMATION

If more than one screen, show locations of each on sketch.