

HARRISON
F 200
7-26-75

MISSISSIPPI
BOARD OF WATER COMMISSIONERS
416 North State Street
Jackson, Mississippi 39201

CODED

WATER WELL DRILLERS LOG

COASTAL DRILLING & SERVICE CO. *Harrison*

date well completed 7/26/75 ROUTE 1 name BOX 618 county well located

LANDOWNER Carl Lygert
Lanain Rd
Apt. Min
(mailing address)
WELL LOCATION:
sec. 2 T. 6 N R. 12 E
W
mit. Sigona
(distance) (direction) (nearest town)
WELL PURPOSE: home
(home, irrigation, municipal, industrial)

description of formations encountered	from	to
<u>top soil</u>	<u>1</u>	<u>2</u>
<u>red clay</u>	<u>2</u>	<u>5</u>
<u>glau</u>	<u>5</u>	<u>10</u>
<u>white sand</u>	<u>10</u>	<u>35</u>
<u>glau</u>	<u>35</u>	<u>45</u>
<u>white sand</u>	<u>45</u>	<u>60</u>
<u>soft gray clay</u>	<u>60</u>	<u>160</u>
<u>hard blue clay</u>	<u>160</u>	<u>295</u>
<u>fine white sand</u>	<u>295</u>	<u>320</u>
<u>concretion sand</u>	<u>320</u>	<u>345</u>

WELL COMPLETION DATA:
(1) diameter (inches) 2"
(2) total depth (feet) 35
(3) static water level (feet) 60 below top of ground.
(4) casing PVC 345
(material) (depth)
_____ if telescope see back.
(size)
(5) screen 10 345
(length) (depth to top)
2" PVC
(size) (material)
(6) pump 1 1/2 45
(HP) (yield gpm)
5hp
(type power)
(7) electric log no
(yes or no)

(organization running log)


(8) how well bottom plugged
29 feet with water
DRILLERS REMARKS:
none

MAR 17 1976

MISS. BB. OF WATER COMM

If well telescopes please sketch and show depths.

GROUND LEVEL

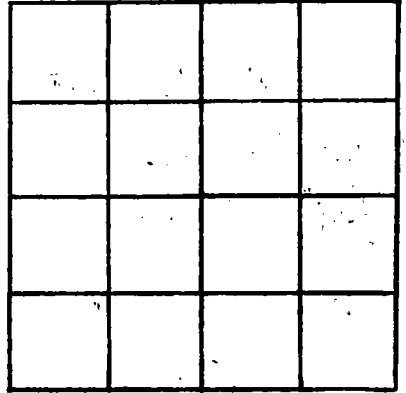

SECTION _____

Please indicate well location X.

ADDITIONAL INFORMATION

If more than one screen, show locations of each on sketch.