

Harrison
F 202
8-20-75

MISSISSIPPI
 BOARD OF WATER COMMISSIONERS
 416 North State Street
 Jackson, Mississippi 39201

CODED

WATER WELL DRILLERS LOG

Aug. 20 19 75 McMill Well Works Harrison
 date well completed firm name county well located

LANDOWNER: <u>Donald Stockstill</u>	description of formations encountered	from	to
<u> Rt. 2, Box 403</u> <u>Yuffort, Miss</u> (mailing address)			
	<u>Clay</u>	<u>0</u>	<u>20</u>
	<u>Sand</u>	<u>20</u>	<u>85</u>
	<u>Slush</u>	<u>85</u>	<u>122</u>
	<u>lime sand</u>	<u>122</u>	<u>185</u>
	<u>Coarse Sand</u>	<u>185</u>	<u>210</u>

WELL LOCATION:
 sec. 23 T 6 N R 12 E 13 S
9 miles North West of Yuffort
 (distance) (direction) (nearest town)

WELL PURPOSE: Home
 (home, irrigation, municipal, industrial)


- WELL COMPLETION DATA:
- (1) diameter (inches) 2"
 - (2) total depth (feet) 210
 - (3) static water level (feet) 88' below above top of ground.
 - (4) casing plastic, 200'
 (material) (depth)
 (size) If telescope see back.
 - (5) screen 10', -
 (length) (depth to top)
2", 3.5
 (size) (material)
 - (6) pump 1 7
 (HP) (yield gpm)
electric
 (type power)
 - (7) electric log no
 (yes or no)
 (organization running log)
 - (8) how well bottom plugged sand
shark

DRILLERS REMARKS:

RECORDED
 NOV 28 1975
 MISS. BD. OF WATER COMM.

If well telescopes please sketch and show depths.

GROUND LEVEL

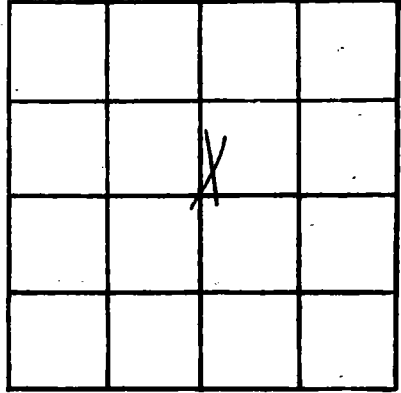

SECTION 23

Please indicate well location X.

ADDITIONAL INFORMATION

Lined area for additional information.

If more than one screen, show locations of each on sketch.