

Harrison
F 204
10-10-75

MISSISSIPPI
 BOARD OF WATER COMMISSIONERS
 416 North State Street
 Jackson, Mississippi 39201

CODED

WATER WELL DRILLERS LOG

Oct. 10 1975 McNeil Well Works Harrison
 date well completed firm name county well located

LANDOWNER Leroy Estes
Rt. 2, Box 74
Thuffport Miss.
 (mailing address)

| description of formations encountered | from | to |
|---------------------------------------|------------|------------|
| <u>sand</u> | <u>0</u> | <u>60</u> |
| <u>B. clay</u> | <u>60</u> | <u>72</u> |
| <u>shale</u> | <u>72</u> | <u>187</u> |
| <u>concrete sand</u> | <u>187</u> | <u>218</u> |
| <u>clay sand</u> | <u>218</u> | <u>289</u> |
| <u>concrete sand</u> | <u>289</u> | <u>346</u> |

WELL LOCATION:
 sec. B T (sec.) 135 R. 12 E. W
2 miles N.W. of Lynn
 (distance) (direction) (nearest town)

WELL PURPOSE: Home
 (home, irrigation, municipal, industrial)

WELL COMPLETION DATA:

(1) diameter (inches) 2"

(2) total depth (feet) 346

(3) static water level (feet) 48' below above top of ground.

(4) casing plastic 336
 (material) (depth)

 If telescope see back.
 (size)

(5) screen 10'
 (length) (depth to top)

2" 3.5
 (size) (material)

(6) pump 1 10
 (HP) (yield gpm)

electric
 (type power)

(7) electric log NO
 (yes or no)

 (organization running log)

(8) how well bottom plugged Sand
Shark


REGISTERED
 NOV 26 1975

DRILLERS REMARKS:

MISS. BD. OF WATER COMM.

If well telescopes please sketch and show depths.

GROUND LEVEL

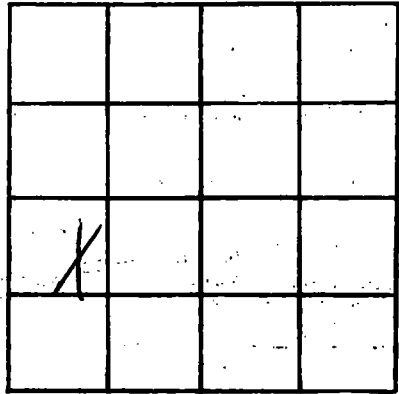

SECTION 13

Please indicate well location X.

ADDITIONAL INFORMATION

If more than one screen, show locations of each on sketch.