

HARRISON  
 F 206  
 3/22/76  
 3/22/76  
 date well completed

MISSISSIPPI  
 BOARD OF WATER COMMISSIONERS  
 416 North State Street  
 Jackson, Mississippi 39201

**CODED**

WATER WELL DRILLERS LOG  
 COASTAL DRILLING & SERVICE CO.

ROUTE 1 BOX 618  
 BILOXI, MISS 39532

Harrison  
 county well located

LANDOWNER: Phyllis Bullard  
Supply Hwy 49 N  
apt. 101  
 (mailing address)

description of formations encountered	from	to
Top Soil	1	5
Red Sandy Clay	5	26
white sand	26	75
Soft Blue Clay	75	130
Coarse white Sand	130	200
Soft Blue Clay	200	330
hard Blue Clay	330	420
fine Water Sand	420	425
Rock	425	427
hard Blue Clay	427	550
fine Water Sand	550	570
Coarse water Sand	570	625

WELL LOCATION:  
 sec 28 T 6N R 12E  
 S W  
5.7 miles W Spencer  
 (distance) (direction) (nearest town)


WELL PURPOSE: Residential  
 (home, irrigation, municipal, industrial)

WELL COMPLETION DATA:

- (1) diameter (inches) 2"
- (2) total depth (feet) 625'
- (3) static water level (feet) 40 below top of ground
- (4) casing POC 615'  
 (material) (depth)
- (size) if telescope see back.
- (5) screen 10' 615'  
 (length) (depth to top)
- 2" POC  
 (size) (material)
- (6) pump no pump  
 (HP) (yield gpm)
- (type power)
- (7) electric log no  
 (yes or no)
- (organization running log)

(8) how well bottom plugged  
2nd hand hand tool


DRILLERS REMARKS:

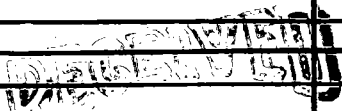

MAR 31 1976

If well telescopes please sketch and show depths.

GROUND LEVEL

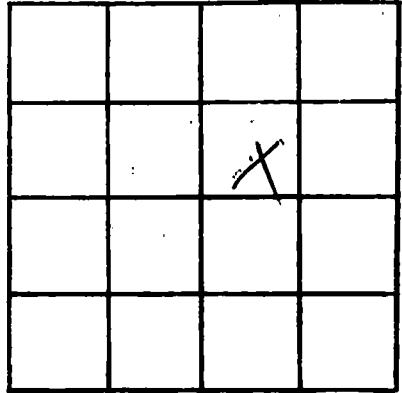

SECTION \_\_\_\_\_

Please indicate well location X.

ADDITIONAL INFORMATION

A series of horizontal lines for recording additional information.

If more than one screen, show locations of each on sketch.