

HARRISON
F 207
4-5-76

MISSISSIPPI
BOARD OF WATER COMMISSIONERS
416 North State Street
Jackson, Mississippi 39201

CODED

WATER WELL DRILLERS LOG
COASTAL DRILLING & SERVICE CO.

4/5
date well completed

1976 ROUTE 1 BOX 618
BILLOXI, MISS. 39532
firm name

Harrison
county well located

LANDOWNER: James Harrison
Rt 2 Box 655H
Gulfport Miss
(mailing address)

WELL LOCATION:
sec 36 T 6N R 12E
S W
(3) Three miles NW of Lordan
(distance) (direction) (nearest town)

WELL PURPOSE: Home
(home, irrigation, municipal, industrial)

WELL COMPLETION DATA:

(1) diameter (inches) 2"

(2) total depth (feet) 500'

(3) static water level (feet) 40 below
top of ground.

(4) casing PVC 490'
(material) (depth)

(size) if telescope see back.

(5) screen 10' 490'
(length) (depth to top)

2" PVC
(size) (material)

(6) pump One 12
(HP) (yield gpm)

Ele
(type power)

(7) electric log No
(yes or no)

(organization running log)

description of formations encountered	from	to
Top Soil	1	3
Red clay	3	15
Red Sand	15	35
White Sand	35	60
Coarse white sand	60	120
Soft Blue Clay	120	230
fine water sand	230	250
Soft Blue Clay	250	280
hard blue clay	280	420
fine water sand	420	450
Coarse water sand	450	500


(8) how well bottom plugged
2" hard water pipe

DRILLERS REMARKS:

RECEIVED
APR 18 1976

If well telescopes please sketch and show depths.

GROUND LEVEL

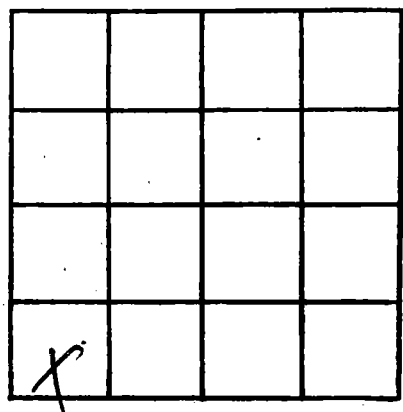

SECTION _____

Please indicate well location X.

ADDITIONAL INFORMATION

A series of horizontal lines for recording additional information.

If more than one screen, show locations of each on sketch.