

Harrison
 F 209
 4/29/76

MISSISSIPPI
 BOARD OF WATER COMMISSIONERS
 416 North State Street
 Jackson, Mississippi 39201

CODED

WATER WELL DRILLERS LOG

4-29-1976 Mc Gill Well Works Inc. Harrison
 date well completed firm name county well located

LANDOWNER: P.C. MO.
Pete McArthur
201 East W. St.
 (mailing address)

description of formations encountered	from	to
	Red clay	0
Red sand	45	84
White clay	84	163
Blue clay	163	218
Fine sand	218	259
Blue clay	259	287
Slush	287	304
COURSE SAND	304	336

WELL LOCATION:
 sec. 21 T. 6N R. 12E
12 1/2 miles WEST of LYMAN
 (distance) (direction) (nearest town)

WELL PURPOSE: home
 (home, irrigation, municipal, industrial)

WELL COMPLETION DATA:

(1) diameter (inches) 2"

(2) total depth (feet) 336'

(3) static water level (feet) 85 below above top of ground.

(4) casing Sch 40 PVC. 326'
 (material) (depth)

 if telescope see back.
 (size)

(5) screen 10'
 (length) (depth to top)

2" S.S.
 (size) (material)

(6) pump 1 6
 (HP) (yield gpm)

Electric
 (type power)

(7) electric log no
 (yes or no)

 (organization running log)

(8) how well bottom plugged sand
shank

DRILLERS REMARKS:


RECEIVED

JAN 20 1977

...ATER COMM

If well telescopes please sketch and show depths.

GROUND LEVEL

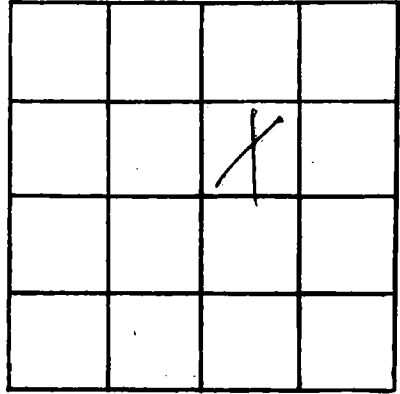

SECTION 21

Please indicate well location X.

ADDITIONAL INFORMATION

Lined area for additional information.

If more than one screen, show locations of each on sketch.