

HARRISON
 F 211
 5/26/76

MISSISSIPPI
 BOARD OF WATER COMMISSIONERS
 416 North State Street
 Jackson, Mississippi 39201

CODED

WATER WELL DRILLERS LOG
 COASTAL DRILLING & SERVICE CO.

Harrison

date well completed

ROUTE 1 BOX 618

county well located

LANDOWNER:

H.R. Pelton

description of formations encountered

from

to

Box 640 B

Top Soil

1 3

Get. mis
 (mailing address)

Red Soil

3 18

WELL LOCATION:

sec. *17* T. *6* N. R. *12* E.
 S. W.

Coarse white sand

18 45

(distance) (direction) (nearest town)

Single sand

45 70

WELL PURPOSE: *Home*
 (home, irrigation, municipal, industrial)

Soft blue clay

70 145

WELL COMPLETION DATA:

Coarse white sand

145 170

- (1) diameter (inches) *2"*
- (2) total depth (feet) *185'*
- (3) static water level (feet) *60* below above top of ground.
- (4) casing *PVC, 125'*
 (material) (depth)

If telescope see back.

- (5) screen *10'* *125'*
 (length) (depth to top)
- 2"* *PVC*
 (size) (material)

- (6) pump *One* *12*
 (HP) (yield gpm)
- Ele.*
 (type power)

- (7) electric log *no*
 (yes or no)

(organization running log)

- (8) how well bottom plugged *2' sand with water*


DRILLERS REMARKS:
Very good well

RECEIVED
 JUN 29 1976

MISS. BD. OF WATER COMMISSIONERS

If well telescopes please sketch and show depths.

GROUND LEVEL

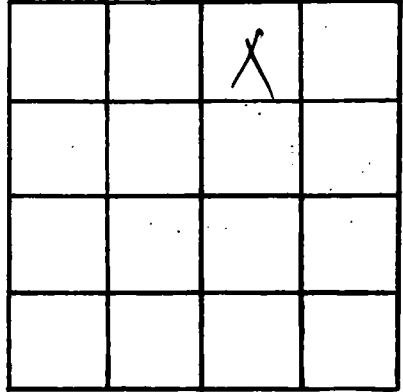

SECTION _____

Please indicate well location X.

ADDITIONAL INFORMATION

If more than one screen,
show locations of each on sketch.