

HARRISON
F 212
6/26/76

MISSISSIPPI
 BOARD OF WATER COMMISSIONERS
 416 North State Street
 Jackson, Mississippi 39201

CODED

WATER WELL DRILLERS LOG
 COASTAL DRILLING & SERVICE CO.

date well completed 6/20 1976 ROUTE 1 BOX 618 Harrison
 town name county well located

LANDOWNER: A.C. Clark
Rt 5
Get, Miss
 (mailing address)

description of formations encountered	from	to
<u>top soil</u>	<u>1</u>	<u>3</u>
<u>Red clay</u>	<u>3</u>	<u>15</u>
<u>white sand</u>	<u>15</u>	<u>35</u>
<u>Soft Blue Clay</u>	<u>35</u>	<u>170</u>
<u>fine white sand</u>	<u>170</u>	<u>190</u>
<u>Coarse white sand</u>	<u>190</u>	<u>210</u>

WELL LOCATION:
 sec 36 T 6 S R. 12 E
W
2 1/2 miles Sut Jarvis
 (distance) (direction) (nearest town)


WELL PURPOSE: home
 (home, irrigation, municipal, industrial)

- WELL COMPLETION DATA:
- (1) diameter (inches) 2"
 - (2) total depth (feet) 205'
 - (3) static water level (feet) 45 below top of ground.
 - (4) casing PVC, 195'
 (material) (depth)
 - If telescope see back.
 (size)
 - (5) screen 10', 195'
 (length) (depth to top)
 - 2", PVC
 (size) (material)
 - (6) pump One 12
 (HP) (yield gpm)
 - Ele
 (type power)
 - (7) electric log no
 (yes or no)
 - (organization running log)

May have that

(8) how well bottom plugged 2" Freshwater Taper

DRILLERS REMARKS: None

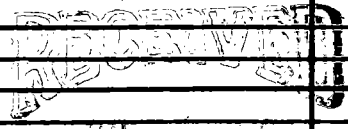

If well telescopes please sketch and show depths.

GROUND LEVEL

	X		

SECTION _____

Please indicate well location X.

ADDITIONAL INFORMATION

If more than one screen, show locations of each on sketch.