

200-4"
325-2"

Harvison
F218
12/12/77

MISSISSIPPI
BOARD OF WATER COMMISSIONERS
416 North State Street
Jackson, Mississippi 39201

CODED

WATER WELL DRILLERS LOG

12/12/77 19 Coastal Drilling Harvison
date well completed firm name county well located
Bilal's

LANDOWNER: J.P. Moore
John Clark Rd
Npt Mis
(mailing address)

WELL LOCATION:
sec 30T-60S R. 12W
1/2 mi S London
(distance) (direction) (nearest town)

WELL PURPOSE: farm
(home, irrigation, municipal, industrial)

WELL COMPLETION DATA:
(1) diameter (inches) 4 1/2"
(2) total depth (feet) 525'
(3) static water level (feet) 80' below above top of ground
(4) casing PVC 510'
(material) (depth)
4 1/2" if telescope see back.
(size)
(5) screen 15' 510'
(length) (depth to top)
2" PVC
(size) (material)
(6) pump one Sh 20
(HP) (yield gpm)
Elc
(type power)
(7) electric log no
(yes or no)
(organization running log)

description of formations encountered	from	to
Top Soil	1	3
Soft Clay	3	18
Hard Rock	18	20
Coarse white sand	20	38
Finer Sand	38	60
Soft blue clay	60	90
Green Sand	90	120
Coarse white sand	120	210
Soft Blue Clay	210	320
Hard Blue Clay	320	440
fine white sand	440	510
Coarse white sand	510	525

CODED

RECEIVED

APR - 7 1978

(8) how well bottom plugged
2" lead wire

DRILLERS REMARKS:

If well telescopes please sketch and show depths.

GROUND LEVEL


200 ft 4" pvc
Casing

310 ft 2" pvc
Casing

15 ft 5" pvc screen

2" hole with valve

If more than one screen,
show locations of each on sketch.

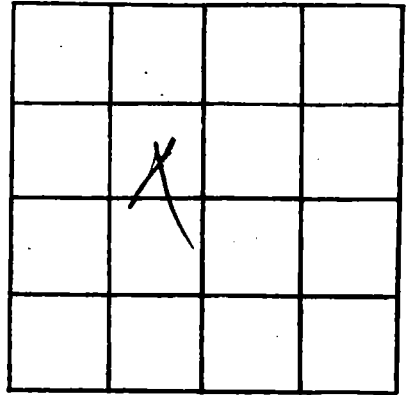

SECTION _____

Please indicate well location X.

ADDITIONAL INFORMATION

Multiple horizontal lines for additional information.