

HARRISON

F 219

12-12-77

MISSISSIPPI BOARD OF WATER COMMISSIONERS 416 North State Street Jackson, Mississippi 39201

CODED

WATER WELL DRILLERS LOG

12/12/77 19 date well completed Coastal Drilling Bilalati, Inc Harrison county well located

LANDOWNER

description of formations encountered

from to

John Clark Rd Apt, Miss (mailing address)

top soil	1	3
Red Clay	3	15
gray sand	15	40
Soft Blue Clay	40	80
Coarse white sand	80	170
Soft Blue Clay	170	270
fine water sand	270	320
hard Blue Clay	320	470
fine water sand	470	525
Coarse water sand	475	525

WELL LOCATION:

sec 36T 6N R 12E S W (3) Three miles SW Lumberton (distance) (direction) (nearest town)

WELL PURPOSE:

(home, irrigation, municipal, industrial) home

WELL COMPLETION DATA:

- (1) diameter (inches) 4 1/2"
- (2) total depth (feet) 525'
- (3) static water level (feet) 60 below top of ground.
- (4) casing AC 510' (material) (depth) 4 1/2" (size) If telescope see back.
- (5) screen 15' 510' (length) (depth to top) 2" (size) PVC (material)
- (6) pump one sub 17 (HP) (yield gpm) 3hp (type power)
- (7) electric log no (yes or no)

CODED

(organization running log)

(8) how well bottom plugged

29 feet with valve

DRILLERS REMARKS:

RECEIVED MAY 5 - 1978

MISS. BD. OF WATER COMM

If well telescopes please sketch and show depths.


GROUND LEVEL

200ft 8" PVC
Casing

310ft 2"
PVC Casing

15ft 2" PVC Screen

2" backwash Valve

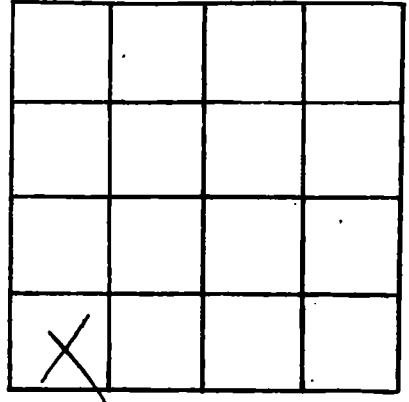

SECTION _____

Please indicate well location X.

ADDITIONAL INFORMATION

If more than one screen, show locations of each on sketch.