

Harrison
 F220
 2/2/78

MISSISSIPPI
 BOARD OF WATER COMMISSIONERS
 416 North State Street
 Jackson, Mississippi 39201

CODED

WATER WELL DRILLERS LOG

Feb 2 1978 BYANT Well Co. HARRISON
 date well completed firm name county well located

LANDOWNER: W. J. Byant
W. J. Byant
Union, Mo.
 (mailing address)

WELL LOCATION:
 sec. 16 T. 6 N. R. 12 E.
7 miles NW of LYMAN
 (distance) (direction) (nearest town)

WELL PURPOSE: Water
 (home, irrigation, municipal, industrial)

WELL COMPLETION DATA:

(1) diameter (inches) 4"

(2) total depth (feet) 41'

(3) static water level (feet) 7' ^{below} _{above} top of ground

(4) casing PVC 40'
 (material) (depth)

 If telescope see back.
 (size)

(5) screen 16' 416'
 (length) (depth to top)

3/8" PVC
 (size) (material)

(6) pump
 (HP) (yield gpm)

 (type power)

(7) electric log NO
 (yes or no)

 (organization running log)

(8) how well bottom plugged

description of formations encountered	from	to
CLAY	1	37
SAND	37	41
CLAY	41	121
FIELD SAND	121	122
CLAY	122	123
SAND	123	124
CLAY	124	200
FIELD SAND	200	311
CLAY	311	312
FIELD SAND	312	410

CODED


RECEIVED

MAR 13 1978

DRILLERS REMARKS:

If well telescopes please sketch and show depths.

GROUND LEVEL

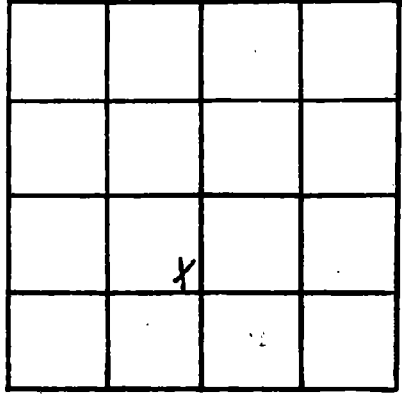

SECTION 10

Please indicate well location X.

ADDITIONAL INFORMATION

If more than one screen, show locations of each on sketch.