

HARRISON

F 221

5-3-78

MISSISSIPPI BOARD OF WATER COMMISSIONERS  
416 North State Street  
Jackson, Mississippi 39201

CODED

WATER WELL DRILLERS LOG

6/3/78 19 Coastal Drilling Service  
date well completed from name to county well located  
Rt 1 Barber Bilbo

LANDOWNER: AW Clark

description of formations encountered

from to

Apex 53 Jayman  
4pt, Miss  
(mailing address)

Top Soil	3	3
Red Clay Sand	3	25
White Sand	25	100
Soft Blue Clay	100	210
Hard Blue Clay	210	260
Soft Blue Clay	260	310
Hard Blue Clay	310	410
fine white sand	410	430
Coarse white sand	430	470

WELL LOCATION:

sec 24 T 6 N R 12 E  
S W  
(2) 1/2 mi W Jayman  
(distance) (direction) (nearest town)

WELL PURPOSE: Home  
(home, irrigation, municipal, industrial)

WELL COMPLETION DATA:

- (1) diameter (inches) 2"
- (2) total depth (feet) 470'
- (3) static water level (feet) 50 below top of ground
- (4) casing PVC 460' (material) (depth)
- (5) screen 10' 460' (length) (depth to top)  
2" PVC (size) (material)
- (6) pump one 10 (HP) (yield gpm)  
Ele (type power)
- (7) electric log w (yes or no)

(organization running log)

(8) how well bottom plugged  
At least with Valve

DRILLERS REMARKS:


CODED

RECEIVED  
JUN 30 1978

MISS. Bd. OF WATER COMM

If well telescopes please sketch and show depths.

GROUND LEVEL

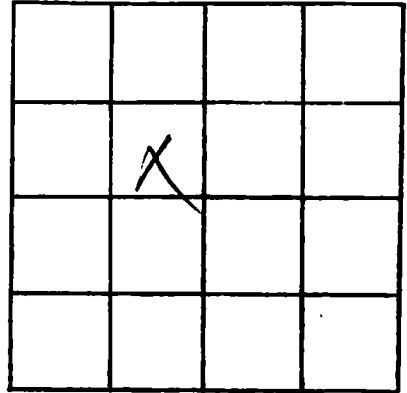

SECTION \_\_\_\_\_

Please indicate well location X.

ADDITIONAL INFORMATION

Lined area for additional information.

If more than one screen, show locations of each on sketch.