

HARRISON  
F227  
7-5-78

MISSISSIPPI  
BOARD OF WATER COMMISSIONERS  
416 North State Street  
Jackson, Mississippi 39201

CODED

WATER WELL DRILLERS LOG

7-5 1978 SWITZER WELL CO. HARRISON  
date well completed firm name county well located

LANDOWNER: MR. DAVID GREGORY  
description of formations encountered from to  
UNKNOWN AT PRESENT

(mailing address)

WELL LOCATION:  
sec. 18 T 6 N R 12 E  
1 miles W of LIZANA  
(distance) (direction) (nearest town)

WELL PURPOSE: HOME  
(home, irrigation, municipal, industrial)

WELL COMPLETION DATA:

(1) diameter (inches) 4" x 2"

(2) total depth (feet) 416 FT

(3) static water level (feet) 68 below above top of ground

(4) casing PVC 396  
(material) (depth)

4" x 2" If telescope see back.  
(size)

(5) screen 20' 386'  
(length) (depth to top)

2" PVC  
(size) (material)

(6) pump 1 15  
(HP) (yield gpm)

220 AC  
(type power)

(7) electric log NO.  
(yes or no)

(organization running log)

(8) how well bottom plugged METAL  
BACK WASH VALVE

DRILLERS REMARKS:


CODED

RECEIVED  
AUG 15 1978

MISSISSIPPI BOARD OF WATER COMMISSIONERS

If well telescopes please sketch and show depths.

GROUND LEVEL

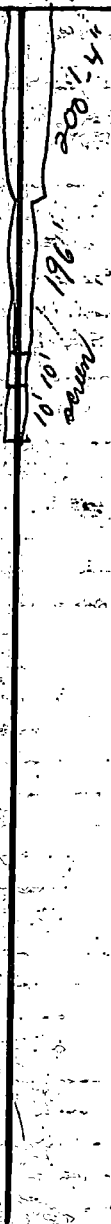

X			

SECTION 18

Please indicate well location X.

ADDITIONAL INFORMATION

If more than one screen, show locations of each on sketch.