

HARRISON
F 229
6-21-78

**MISSISSIPPI
BOARD OF WATER COMMISSIONERS**
416 North State Street
Jackson, Mississippi 39201

CODED

WATER WELL DRILLERS LOG

6-21-78 date well completed McNeil Well Works, Inc. firm name Harrison county well located

LANDOWNER:
Echo Well Estates
McThuire Edwards:
(mailing address)

WELL LOCATION:
sec. 95 T 6 R 12 E
3 miles S.W. of Lyman
(distance) (direction) (nearest town)

WELL PURPOSE: home
(home, irrigation, municipal, industrial)

WELL COMPLETION DATA:

(1) diameter (inches) 2"

(2) total depth (feet) 588'

(3) static water level (feet) 65' ^{below} top of ground

(4) casing PVC sch. 40 578' (material) (depth)

— If telescope see back. (size)

(5) screen 10' (length) (depth to top)
2" (size) plastic (material)

(6) pump 1 (HP) 9 (yield gpm)
electric (type power)

(7) electric log no (yes or no)

— (organization running log)

(8) how well bottom plugged and short.

description of formations encountered	from	to
Sand - mud	0	20
mud	20	160
mud sand	160	180
sand	180	200
sand mud	200	220
mud	220	240
mud sand	240	280
mud	280	304
mud	304	325
mud-sand	325	346
sand	346	567
c. sand	567	588

CODED

RECEIVED


NOV 28 1978

DRILLERS REMARKS:

MISS. Bd. OF WATER COMMISSIONERS

If well telescopes please sketch and show depths.

GROUND LEVEL

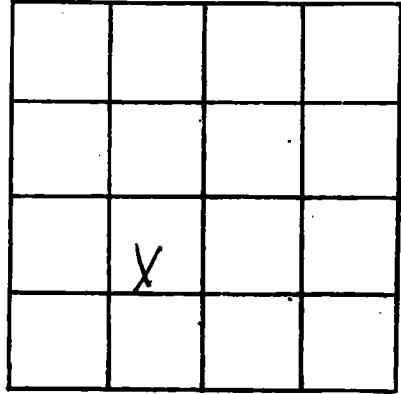

SECTION 35

Please indicate well location X.

ADDITIONAL INFORMATION

If more than one screen,
show locations of each on sketch.