

HARRISON  
 F 232  
 6-22-78

MISSISSIPPI  
 BOARD OF WATER COMMISSIONERS  
 416 North State Street  
 Jackson, Mississippi 39201

**CODED**

WATER WELL DRILLERS LOG

6/22/78 19 Coated Drilling Harrison  
 date well completed firm name county well located  
 Biloxi Miss

LANDOWNER	description of formations encountered	from	to
Carl Jett	Top Soil	1	3
Echo Hill	Super Sand	3	20
apt, Miss	Coarse white Sand	20	600
(mailing address)	Soft blue Clay	600	230
	Hard Blue Clay	230	460
	fine white sand	460	480
	Coarse white Sand	480	510

WELL LOCATION:  
 sec 33 T 6 N R 12 E  
 S W  
 (5.7 miles) NW Joplin  
 (distance) (direction) (nearest town)

WELL PURPOSE: home  
 (home, irrigation, municipal, industrial)

**CODED**

WELL COMPLETION DATA:

(1) diameter (inches) 2"  
 (2) total depth (feet) 510'  
 (3) static water level (feet) 60 below top of ground  
 (4) casing PVC 500'  
 (material) (depth)  
 (size) If telescope see back.  
 (5) screen 10' 500'  
 (length) (depth to top)  
 2" PVC  
 (size) (material)  
 (6) pump One 14  
 (HP) (yield gpm)  
 Ele  
 (type power)  
 (7) electric log no  
 (yes or no)  
 (organization running log)

Miss. Board of Water Comm.


FEB 8 1979

(8) how well bottom plugged  
 2" packed with gravel  
 DRILLERS REMARKS:

**RECORDED**

If well telescopes please sketch and show depths.

GROUND LEVEL

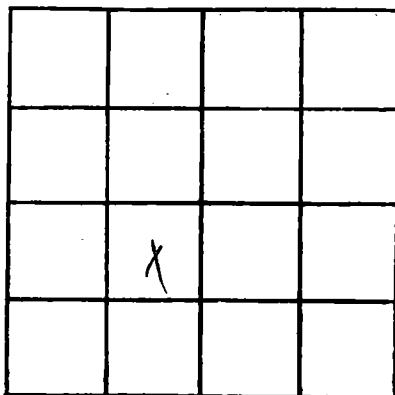

SECTION \_\_\_\_\_

Please indicate well location X.

ADDITIONAL INFORMATION

If more than one screen, show locations of each on sketch.