

HARRISON

F 238

11-03-78

MISSISSIPPI BOARD OF WATER COMMISSIONERS
416 North State Street
Jackson, Mississippi 39201

CODED

WATER WELL DRILLERS LOG

11/3/78 19 Coastal Drilling Harrison
date/well completed firm name county well located
Bilal Min

LANDOWNER: James Sells

Hwy 153
Grt in jct
(mailing address)

description of formations encountered

from to

top soil	1	3
Red Clay	3	15
fine sand	15	40
Coar. white sand	40	70
Soft Blue Clay	70	230
logs	230	235
fine water sand	235	250
hard blue clay	250	405
fine water sand	405	425
Coar. water sand	425	463

WELL LOCATION:

sec 24 T 6 N R 12 E
S W
2 1/2 miles West Lumberton
(distance) (direction) (nearest town)

WELL PURPOSE:

home
(home, irrigation, municipal, industrial)

WELL COMPLETION DATA:

- (1) diameter (inches) 2"
- (2) total depth (feet) 463'
- (3) static water level (feet) 60 below top of ground.
- (4) casing PVC 453'
(material) (depth)

(size) If telescope see back.

- (5) screen 10' 453'
(length) (depth to top)

2" PVC
(size) (material)

- (6) pump one 8
(HP) (yield gpm)

5hp
(type power)

- (7) electric log no
(yes or no)

(organization running log)

- (8) how well bottom plugged 2" pack with valve

DRILLERS REMARKS:

CODED



Miss. Board of Water Comm.

APR 23 1979

RECEIVED

If well telescopes please sketch and show depths.

GROUND LEVEL

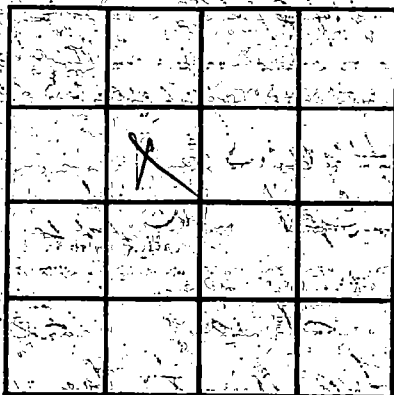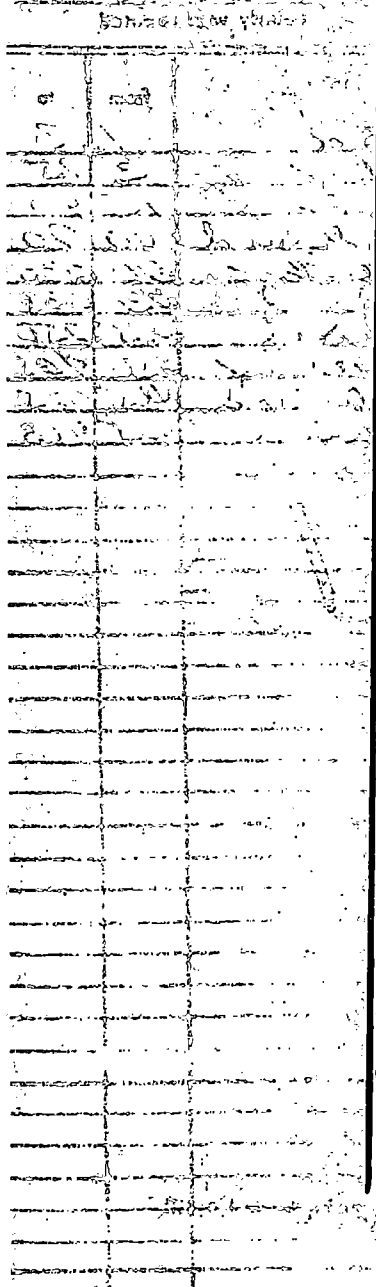

SECTION _____

Please indicate well location X.

ADDITIONAL INFORMATION

Handwritten notes in the additional information section, including the number '156' and '200'.

If more than one screen, show locations of each on sketch.