

**HARRISON**  
**F 240**  
**4-18-79**

MISSISSIPPI  
 BOARD OF WATER COMMISSIONERS  
 416 North State Street  
 Jackson, Mississippi 39201

**CODED**

WATER WELL DRILLERS LOG

April 18 1979 Duncan Well Drilling Harrison  
 date well completed firm name county well located

LANDOWNER: Ellis Pearson  
Hernwood Trailer Park  
Gulfport, Ms.  
 (mailing address)

description of formations encountered	from	to
<u>TOP Sand</u>	<u>0</u>	<u>60</u>
<u>White Clay</u>	<u>60</u>	<u>150</u>
<u>Blue Clay</u>	<u>150</u>	<u>410</u>
<u>Fine Sand</u>	<u>410</u>	<u>493</u>
<u>Course Sand</u>	<u>493</u>	<u>504</u>

WELL LOCATION:  
 sec 35 T 7S R 12E  
5 miles W. of Rugent  
 (distance) (direction) (nearest town)

WELL PURPOSE: Home  
 (home, irrigation, municipal, industrial)

- WELL COMPLETION DATA:
- (1) diameter (inches) 2"
  - (2) total depth (feet) 504
  - (3) static water level (feet) 60' below above top of ground.
  - (4) casing PVC 494'  
 (material) (depth)
  - (5) screen 10' 504'  
2" (length) (depth to top)  
2" (size) PVC (material)
  - (6) pump 1 10  
 (HP) (yield gpm)  
electric (type power)
  - (7) electric log                       
 (yes or no)
  - (8) how well bottom plugged Sand  
Shark

DRILLERS REMARKS:                     

**CODED**


Miss. Board of Water Comm.

JUN - 5 1979

**RECEIVED**

If well telescopes please sketch and show depths.

GROUND LEVEL

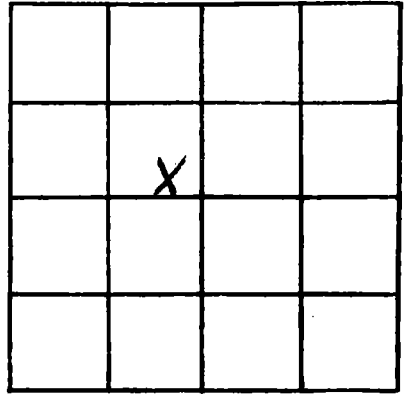

SECTION 35

Please indicate well location X.

ADDITIONAL INFORMATION

If more than one screen, show locations of each on sketch.