

HARRISON
F242
06-16-79

MISSISSIPPI
 BOARD OF WATER COMMISSIONERS
 416 North State Street
 Jackson, Mississippi 39201

CODED

WATER WELL DRILLERS LOG

June 16 1979 Harrison Well Drilling Harrison
 date well completed firm name county well located

LANDOWNER: Peter Fisher
Rt. 7 Box 352
Mulport, Mo. 39503
 (mailing address)

description of formations encountered	from	to
<u>top sand</u>	<u>0</u>	<u>38</u>
<u>Blue clay</u>	<u>38</u>	<u>543</u>
<u>fine sand</u>	<u>543</u>	<u>620</u>
<u>course sand</u>	<u>620</u>	<u>651</u>

WELL LOCATION:
 sec. 10 T 6 N R. 12 E
5 miles W of Lyman
 (distance) (direction) (nearest town)

CODED

WELL PURPOSE: Home
 (home, irrigation, municipal, industrial)

- WELL COMPLETION DATA:
- (1) diameter (inches) 3"
 - (2) total depth (feet) 651 ft
 - (3) static water level (feet) 90' below top of ground.
 - (4) casing PVC 641'
 (material) (depth)
 - _____ If telescope see back.
 (size)
 - (5) screen 10' 641'
 (length) (depth to top)
 - 2" _____
 (size) (material)
 - (6) pump 1/40 6
 (HP) (yield gpm)
 - electric
 (type power)
 - (7) electric log _____
 (yes or no)
 - _____ (organization running log)
 - (8) how well bottom plugged Sand
 - Shank

DEPT. OF NATURAL RESOURCES
 BUREAU OF LAND & WATER RESOURCES


JAN 15 1980

DRILLERS REMARKS:

RECEIVED

If well telescopes please sketch and show depths.

GROUND LEVEL

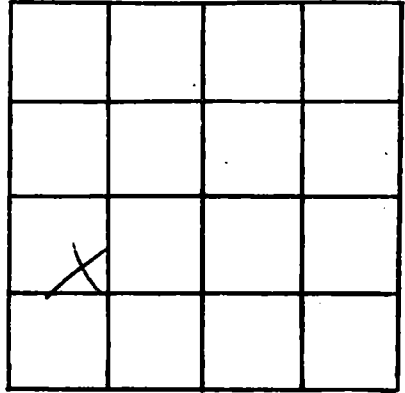

SECTION 10

Please indicate well location X.

ADDITIONAL INFORMATION

If more than one screen,
show locations of each on sketch.