

HARRISON
 F244
 11-17-79

MISSISSIPPI
 BOARD OF WATER COMMISSIONERS
 416 North State Street
 Jackson, Mississippi 39201

CODED

WATER WELL DRILLERS LOG

Nov. 17 1979 Duncan Well Drilling Harrison
 date well completed firm name county well located

LANDOWNER: Orlene Wilcox
Box 339 Rt. #2
Sheppard Mo.
 (mailing address)

| description of formations encountered | from | to |
|---------------------------------------|----------|-----------|
| <u>Sand & gravel</u> | <u>0</u> | <u>30</u> |

WELL LOCATION:
 sec. 28 T 3 N R 12 E
10 miles NW of Long Beach
 (distance) (direction) (nearest town)

CODED

WELL PURPOSE: Windmill
 (home, irrigation, municipal, industrial)

- WELL COMPLETION DATA:
- (1) diameter (inches) 2"
 - (2) total depth (feet) 30 ft.
 - (3) static water level (feet) 6' ^{below} _{above} top of ground.
 - (4) casing PVC, 20'
 (material) (depth)
 (size) If telescope see back.
 - (5) screen 10', 20'
 (length) (depth to top)
2", PVC
 (size) (material)
 - (6) pump _____
 (HP) (yield gpm)
 (type power)
 - (7) electric log _____
 (yes or no)
 (organization running log)
 - (8) how well bottom plugged _____

DEPT. OF NATURAL RESOURCES
 BUREAU OF LAND & WATER RESOURCES


DRILLERS REMARKS:

JAN 15 1980

RECEI

If well telescopes please sketch and show depths.

GROUND LEVEL

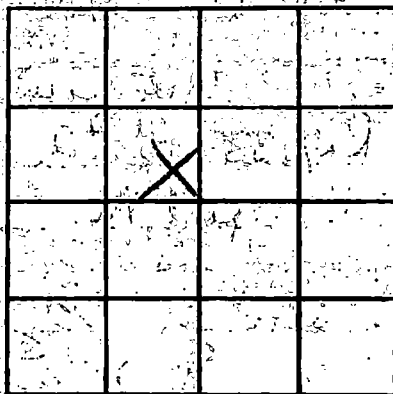

SECTION 28

Please indicate well location X.

ADDITIONAL INFORMATION

If more than one screen, show locations of each on sketch.