

HARRISON
 F 246
 1-16-80

MISSISSIPPI
 BOARD OF WATER COMMISSIONERS
 416 North State Street
 Jackson, Mississippi 39201

CODED

WATER WELL DRILLERS LOG

1-16-80 date well completed
 Braden Rump and Harrison firm name
 Well Source, Inc. county well located

LANDOWNER:
 Janelle Ruffin
 Rt. 2, Box 283
 Gulfport, MS
 (mailing address)

description of formations encountered	from	to
Clay	0	20
Sand	20	40
Gravel	40	60
Sand	60	80

WELL LOCATION:
 sec. 4 T. 6 R. 12
 2 1/2 miles S E W of LIZONA
 (distance) (direction) (nearest town)

WELL PURPOSE: HOME
 (home, irrigation, municipal, industrial)

CODED

- WELL COMPLETION DATA:
- (1) diameter (inches) 2"
 - (2) total depth (feet) 80'
 - (3) static water level (feet) 28 below top of ground.
 - (4) casing PVC total
 (material) (depth)
 2" (size) if telescope see back.
 - (5) screen 10' 70'
 (length) (depth to top)
 2" .008 PVC underlain
 (size) (material)
 - (6) pump 1 10
 (HP) (yield gpm)
 230 10
 (type power)
 - (7) electric log NO
 (yes or no)
- (organization running log)
- (8) how well bottom plugged
 2" sand shark

DRILLERS REMARKS:
 NO TAIL PIPE


DEPT. OF NATURAL RESOURCES
 BUREAU OF LAND & WATER RESOURCES

FEB 15 1980

RECEIVED

If well telescopes please sketch and show depths.

GROUND LEVEL

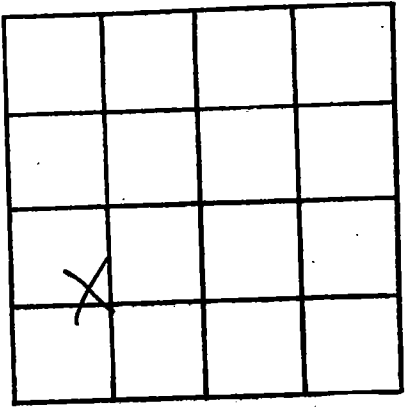

SECTION 19

Please indicate well location X.

ADDITIONAL INFORMATION

Lined area for additional information.

If more than one screen, show locations of each on sketch.