

HARRISON

MISSISSIPPI
BOARD OF WATER COMMISSIONERS
416 North State Street
Jackson, Mississippi 39201

CODED

WATER WELL DRILLERS LOG

F247
1-73-80

1-83
date well completed

1980 Braden Pump & Well
firm name

HARRISON
county well located

Service, Inc.

LANDOWNER: Buzz Becker

58 Wood Forest DR.

Gulfport, MS 39501
(mailing address)

WELL LOCATION:

sec. 3 T. 7 S. R. 12 W.
6 1/2 miles N.W. of Lyman
(distance) (direction) (nearest town)

WELL PURPOSE: Home
(home, irrigation, municipal, industrial)

WELL COMPLETION DATA:

- (1) diameter (inches) 2" x 4"
- (2) total depth (feet) 380'
- (3) static water level (feet) 46' below top of ground.
- (4) casing PVC total
(material) (depth)
4" x 2" if telescope see back.
(size)
- (5) screen 10' 365'
(length) (depth to top)
2" PVC under bar
(size) (material)
- (6) pump has not put pump on
(HP) (yield gpm)
(type power)
- (7) electric log NO
(yes or no)
(organization running log)
- (8) how well bottom plugged
2" sand shark

description of formations encountered

from to

Red clay	0	50
sand	50	70
Blue clay	70	335
sand	335	380

CODED

DEPT. OF NATURAL RESOURCES
BUREAU OF LAND & WATER RESOURCES

JUN 25 1980

RECEIVED

DRILLERS REMARKS:

5' tail pipe

If well telescopes please sketch and show depths.

GROUND LEVEL

4" sch 40
PVC

180'


2" sch 40
PVC

365'

.008 PVC
underbar

380'

2" sand shark

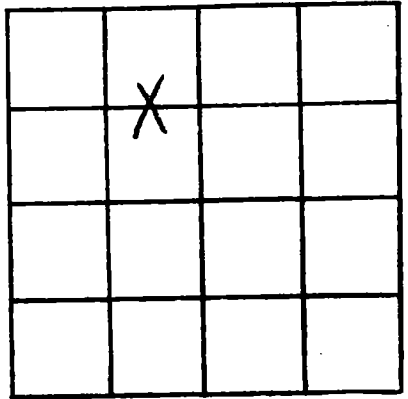

SECTION 3

Please indicate well location X.

ADDITIONAL INFORMATION

If more than one screen,
show locations of each on sketch.