

HARRISON
 F250
 5-15-80

MISSISSIPPI
 BOARD OF WATER COMMISSIONERS
 416 North State Street
 Jackson, Mississippi 39201

CODED

WATER WELL DRILLERS LOG

5-15 1980 Braden Pump & Well Service, Inc HARRISON
 date well completed firm name county well located

LANDOWNER: Alvin Russell Rt. 2, Box 155 Gulfport, MS 39503 (mailing address)	description of formations encountered	from	to
WELL LOCATION: sec. 7 T. 6 S. R. 10 W. miles in of Lizana (distance) (direction) (nearest town)	Clay	0	100
WELL PURPOSE: Home (home, irrigation, municipal, industrial)	Sand	100	120
WELL COMPLETION DATA: (1) diameter (inches) 4" x 2"	Clay	120	130
(2) total depth (feet) 380'	Sand	130	160
(3) static water level (feet) 50 below top of ground.	Clay	160	352
(4) casing PVC, total, 4" x 2" (size) If telescope see back.	Sand	352	372
(5) screen 10' (length), 370' (depth to top) 2" (size), corr PVC underlain (material)	Clay	372	380
(6) pump 1 sub. (HP) 20 (yield gpm) 230 (type power)			
(7) electric log NO (yes or no)			
(8) how well bottom plugged 2" sand shark			
DRILLERS REMARKS: no tail pipe			

CODED

DEPT OF NATURAL RESOURCES
 BUREAU OF LAND & WATER RESOURCES

JUL - 2 1980

RECEIVED

If well telescopes please sketch and show depths.

GROUND LEVEL

4" sch 40
PVC


200'

2" sch 40
PVC

370'

20% PVC
underbar
screen

380'

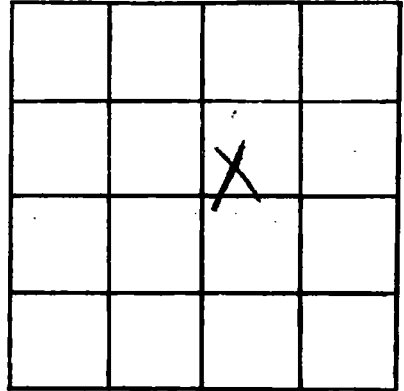

SECTION 7

Please indicate well location X.

ADDITIONAL INFORMATION

If more than one screen,
show locations of each on sketch.