

HARRISON
F 252
6-3-80

MISSISSIPPI
BOARD OF WATER COMMISSIONERS
 416 North State Street
 Jackson, Mississippi 39201

CODED

WATER WELL DRILLERS LOG

6-3 1980 Murphy Well Drilling Throuvan
 date well completed firm name county well located

LANDOWNER: Eula Jones
Baker & Ave. St.
Hulbert, Mo. 39503
 (mailing address)

description of formations encountered	from	to
Clay	0	27
Sand	27	73
Blue Clay	73	240
fine sand	240	280
Blue Clay	280	450
fine sand	450	470
course sand	470	483

WELL LOCATION:
 sec. 31-6 N 12 E
 (S) (W)
5 miles W of Apas
 (distance) (direction) (nearest town)

WELL PURPOSE: Home
 (home, irrigation, municipal, industrial)

WELL COMPLETION DATA:
 (1) diameter (inches) 2 1/2
 (2) total depth (feet) 483 ft.
 (3) static water level (feet) 50' ^{below} _{above} top of ground.
 (4) casing PVC 483
 (material) (depth)
 (size) If telescope see back.
 (5) screen 10' 473
 (length) (depth to top)
2 1/2" PVC
 (size) (material)
 (6) pump 1 8
 (HP) (yield gpm)
electric
 (type power)
 (7) electric log _____
 (yes or no)

(organization running log)
 (8) how well bottom plugged Sand
Mark

DRILLERS REMARKS:

CODED


DEPT. OF NATURAL RESOURCES
 BUREAU OF LAND & WATER RESOURCES

SEP 22 1980

RECEIVED

If well telescopes please sketch and show depths.

GROUND LEVEL

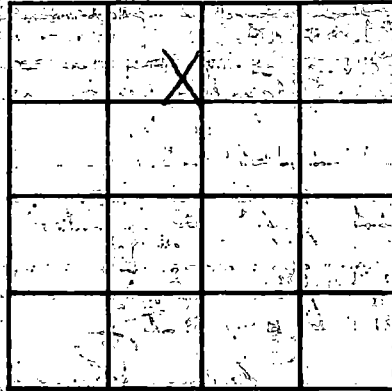

SECTION 31

Please indicate well location, X.

ADDITIONAL INFORMATION

If more than one screen, show locations of each on sketch.