

MISSISSIPPI DEPARTMENT OF NATURAL RESOURCES

Bureau of Land and Water Resources

Southport Mall

P.O. Box 10631

Jackson, Mississippi 39209

CODED

WATER WELL DRILLERS LOG

COASTAL DRILLING & SERVICE CO.

ROUTE 1 BOX 618

BLOOM, MISS. 39532

*Harrison*  
county well located

HARRISON  
F259  
6-27-80  
6/27/80  
date well completed

LANDOWNER Mike Suber

description of formations encountered

from to

John Cook Road  
apt min  
(mailing address)

<u>top soil</u>	<u>1</u>	<u>3</u>
<u>red clay</u>	<u>3</u>	<u>18</u>
<u>Coarse white sand</u>	<u>18</u>	<u>40</u>
<u>Soft Blue Clay</u>	<u>40</u>	<u>90</u>
<u>fine white sand</u>	<u>90</u>	<u>110</u>
<u>Light Blue Clay</u>	<u>110</u>	<u>220</u>
<u>light blue clay</u>	<u>220</u>	<u>460</u>
<u>fine water sand</u>	<u>460</u>	<u>475</u>
<u>good water sand</u>	<u>475</u>	<u>500</u>

WELL LOCATION:

sec 25 T 6 S R 12 E W  
(11/2 miles West Bluff Branch)  
(distance) (direction) (nearest town)

WELL PURPOSE:

(home, irrigation, municipal, industrial) home

WELL COMPLETION DATA:

- (1) diameter (inches) 2"
- (2) total depth (feet) 500'
- (3) static water level (feet) 60' below above-top of ground.
- (4) casing PVC 490'  
(material) (depth)
- (size) If telescope see back.
- (5) screen 10' 490'  
(length) (depth to top)
- 2" AK  
(size) (material)
- (6) pump one 10  
(HP) (yield gpm)
- 3/4  
(type power)
- (7) electric log no  
(yes or no)

(organization running log)

(8) how well bottom plugged 2' back with blue

DRILLERS REMARKS:

CODED


DEPT. OF NATURAL RESOURCES  
BUREAU OF LAND & WATER RESOURCES

JAN 21 1981

RECEIVED

If well telescopes please sketch and show depths.

GROUND LEVEL

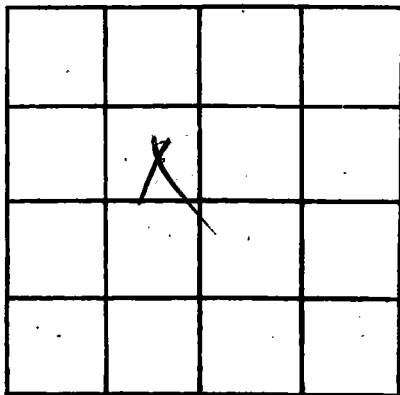

SECTION \_\_\_\_\_

Please indicate well location X.

**ADDITIONAL INFORMATION**

If more than one screen, show locations of each on sketch.