

MISSISSIPPI DEPARTMENT OF NATURAL RESOURCES

Bureau of Land and Water Resources

Southport Mall

P.O. Box 10631

Jackson, Mississippi 39209

WATER WELL DRILLERS LOG

**CODED**

HARRISON  
E 260  
11/10/80  
11/10/80

date well completed

firm name

county well located

Lyman Well Co.

Harrison

LANDOWNER:

Lippi Luppitt  
Herman Ladner Rd.

description of formations encountered

from

to

Lyana, Md  
(mailing address)

<u>red clay</u>	<u>0</u>	<u>6</u>
<u>yellow clay</u>	<u>6</u>	<u>20</u>
<u>grey clay</u>	<u>30</u>	<u>70</u>
<u>shale fine</u>	<u>70</u>	<u>156</u>

WELL LOCATION:

30 12W  
5 13E  
sec. 5 T. 5 N. R. 13 E  
3 miles S of Lyman  
(distance) (direction) (nearest town)

WELL PURPOSE:

(home, irrigation, municipal, industrial)

WELL COMPLETION DATA:

- (1) diameter (inches) 2
- (2) total depth (feet) 156
- (3) static water level (feet) 11 below above top of ground.
- (4) casing PVC 146  
(material) (depth)  
(size) if telescope see back.
- (5) screen 10' 146  
(length) (depth to top)  
6 PVC  
(size) (material)
- (6) pump 1 15  
(HP) (yield gpm)  
elec  
(type power)
- (7) electric log no  
(yes or no)

(organization running log)

(8) how well bottom plugged yes

**CODED**

DEPT. OF NATURAL RESOURCES  
BUREAU OF LAND & WATER RESOURCES


FEB 19 1981

**RECEIVED**

DRILLERS REMARKS:

If well telescopes please sketch and show depths.

GROUND LEVEL

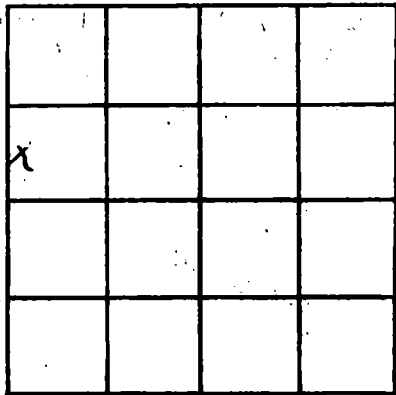

SECTION 30

Please indicate well location X.

ADDITIONAL INFORMATION

If more than one screen, show locations of each on sketch.