

MISSISSIPPI DEPARTMENT OF NATURAL RESOURCES

Bureau of Land and Water Resources

Southport Mall

P.O. Box 10631

CODED

Jackson, Mississippi 39209

WATER WELL DRILLERS LOG

HARRISON
F 261
12/12/80

date well completed 1980 Duncan Well Drilling firm name Harrison county well located

LANDOWNER: A. W. Drew
3001 Lizabeth Dr.
Morgan City, La.
(mailing address)

description of formations encountered	from	to
<u>sand</u>	<u>0</u>	<u>25</u>
<u>clay</u>	<u>25</u>	<u>205</u>
<u>fine sand</u>	<u>205</u>	<u>230</u>
<u>Blue Clay</u>	<u>230</u>	<u>295</u>
<u>Course Sand</u>	<u>295</u>	<u>315</u>

WELL LOCATION:

sec. 35 6 N 12 E
S W
5 miles SW of Sauvignat
(distance) (direction) (nearest town)

WELL PURPOSE: Home
(home, irrigation, municipal, industrial)

WELL COMPLETION DATA:

- (1) diameter (inches) 2"
- (2) total depth (feet) 315 ft.
- (3) static water level (feet) 40 below above top of ground.
- (4) casing PVC, 305
(material) (depth)
1 If telescope see back.
(size)
- (5) screen 10', 305
(length) (depth to top)
2", PVC
(size) (material)
- (6) pump _____ (HP) _____ (yield gpm)
electric
(type power)
- (7) electric log _____ (yes or no)

(organization running log)

(8) how well bottom plugged Sand
Shark

DRILLERS REMARKS: Owner
installed his own
pump


DEPT. OF NATURAL RESOURCES
BUREAU OF LAND & WATER RESOURCES

MAR 18 1981

RECEIVED

If well telescopes please sketch and show depths.

GROUND LEVEL

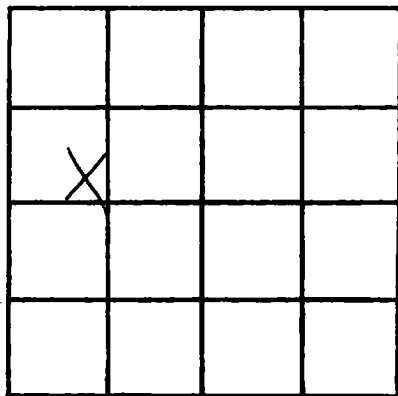

SECTION 35

Please indicate well location X.

ADDITIONAL INFORMATION

If more than one screen, show locations of each on sketch.