

MISSISSIPPI DEPARTMENT OF NATURAL RESOURCES

Bureau of Land and Water Resources

Southport Mall

P.O. Box 10631

Jackson, Mississippi 39209

WATER WELL DRILLERS LOG

CODED

HARRISON
F 262
3/6/81

3/6/81 19 Lyman Well Co. Harrison
date well completed firm name county well located

LANDOWNER: Kenny Farahn
3308 W Railroad St.
Gulfport Ms 39501
(mailing address)

description of formations encountered	from	to
<u>yellow clay</u>	<u>0</u>	<u>14</u>
<u>Red clay & sand</u>	<u>14</u>	<u>38</u>
<u>Grey & Blue clay</u>	<u>38</u>	<u>240</u>
<u>SAND</u>	<u>240</u>	<u>260</u>

WELL LOCATION:
sec. 10 T. 6 N. R. 12 E.
12 miles S of Long Beach
(distance) (direction) (nearest town)


WELL PURPOSE: Home
(home, irrigation, municipal, industrial)

- WELL COMPLETION DATA:
- (1) diameter (inches) 2"
 - (2) total depth (feet) 260'
 - (3) static water level (feet) 78 below above top of ground.
 - (4) casing PVC 250'
(material) (depth)
2" If telescope see back.
(size)
 - (5) screen 10' 250'
(length) (depth to top)
2" PVC
(size) (material)
 - (6) pump 1 1/2 13
(HP) (yield gpm)
electric
(type power)
 - (7) electric log No
(yes or no)
No
(organization running log)

(8) how well bottom plugged sand
shark

DRILLERS REMARKS:

CODED

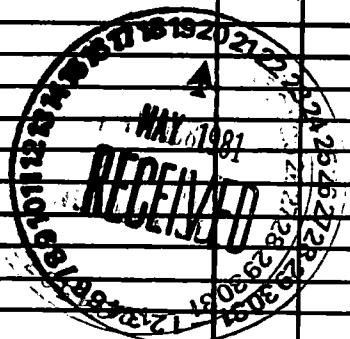

DEPT. OF NATURAL RESOURCES
BUREAU OF LAND & WATER RESOURCES

MAY 20 1981

RECEIVED

If well telescopes please sketch and show depths.

GROUND LEVEL

			7

SECTION _____

Please Indicate well location 'X'.

ADDITIONAL INFORMATION

If more than one screen, show locations of each on sketch.

