

MISSISSIPPI DEPARTMENT OF NATURAL RESOURCES

Bureau of Land and Water Resources

Southport Mall

P.O. Box 10631

Jackson, Mississippi 39209

WATER WELL DRILLERS LOG

CODED

HARRISON
F264
2/16/81

2/16/81 date well completed
Suncor Well Drilling firm name
Harrison county well located

LANDOWNER: William Bradine
P.O. Box 1269
Gpt. Ms.
(mailing address)

description of formations encountered	depth	
	from	to
Clay	0	60
Leeward	60	85
Course Sand	85	100

WELL LOCATION:
sec 18 T 4 N R 12 E
1 1/2 miles (distance) S (direction) of Bogalusa (nearest town)

WELL PURPOSE: Home
(home, irrigation, municipal, industrial)

WELL COMPLETION DATA:

(1) diameter (inches) 2"

(2) total depth (feet) 100 ft.

(3) static water level (feet) 28' below top of ground.

(4) casing PVC (material), 90' (depth).

(5) screen 10' (length), 90' (depth to top), 2" (size), PVC (material).

(6) pump 1 (HP), 10 (yield gpm), electric (type power).

(7) electric log (yes or no)

(organization running log)

(8) how well bottom plugged Sand
Sharp

DRILLERS REMARKS:


CODED

DEPT. OF NATURAL RESOURCES
BUREAU OF LAND & WATER RESOURCES

MAY 18 1981
RECEIVED

If well telescopes please sketch and show depths.

GROUND LEVEL

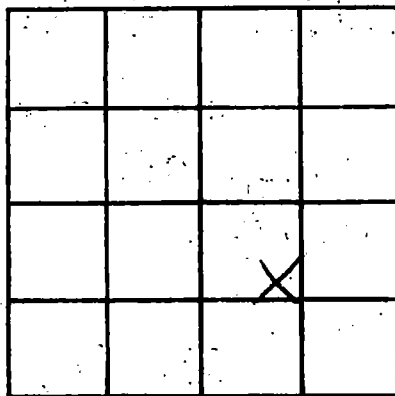

SECTION 18

Please indicate well location X.

ADDITIONAL INFORMATION

If more than one screen, show locations of each on sketch.