

Harrison
 R 266
 6-27-81

MISSISSIPPI
 BOARD OF WATER COMMISSIONERS
 416 North State Street
 Jackson, Mississippi 39201

CODED

WATER WELL DRILLERS LOG
 BRADEN PUMP AND WELL SERVICE, INC.

6-27-1981 date well completed
 ROUTE 1, BOX 489 HARRISON
 SAUCIER, MS 39574 county well located

LANDOWNER:	description of formations encountered	from	to
Cleve Sanders Rt 3, Box 1084	CLAY	0	20
Gulfport, MS 39503 (mailing address)	SAND	20	60
WELL LOCATION:	CLAY	60	80
sec. 36 T 6 N R 12 E	SAND	80	105
2 1/2 miles SW of Lyman (distance) (direction) (nearest town)	CLAY	105	115
WELL PURPOSE: home (home, irrigation, municipal, industrial)	SAND	115	135
WELL COMPLETION DATA:	CLAY	135	145
(1) diameter (inches) 2"	SAND	145	250
(2) total depth (feet) 540	CLAY	250	500
(3) static water level (feet) 75 below above top of ground.	SAND	500	540
(4) casing PVC, 1041' (material) (depth) 2" (size) If telescope see back.			
(5) screen 10', 530' (length) (depth to top) 2", PVC underbar (size) (material)			
(6) pump 1 (HP) 10 (yield gpm) 220 (type power)			
(7) electric log no (yes or no)			
(organization running log)			
(8) how well bottom plugged 2" sand shark			
DRILLERS REMARKS: no tail pipe			


DEPT. OF NATURAL RESOURCES
 BUREAU OF LAND & WATER RESOURCES

JUL 31 1981

RECEIVED

If well telescopes please sketch and show depths.

GROUND LEVEL

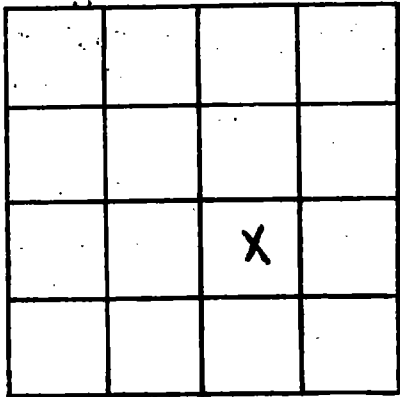

SECTION 36

Please indicate well location X.

ADDITIONAL INFORMATION

If more than one screen, show locations of each on sketch.