

MISSISSIPPI DEPARTMENT OF NATURAL RESOURCES

Bureau of Land and Water Resources

Southport Mall

P.O. Box 10631

**CODED**

Jackson, Mississippi 39209

**WATER WELL DRILLERS LOG**

**HARRISON**  
**F268**  
**8/3/81**

8/3/81 date well completed  
 Lyman Well Co. firm name  
 Harrison county well located

LANDOWNER: Hoyt Clark  
 Rt. 2, Box 392-H  
 Apt. Ths 39503  
 (mailing address)

WELL LOCATION:  
 sec. 22 T 4 N R 12 E  
 5 miles W of Lyman  
 (distance) (direction) (nearest town)

WELL PURPOSE: Home  
 (home, irrigation, municipal, industrial)

WELL COMPLETION DATA:  
 (1) diameter (inches) 2"  
 (2) total depth (feet) 225'  
 (3) static water level (feet) 63 below top of ground.  
 (4) casing PVC 215'  
 (material) (depth)  
 2" If telescope see back.  
 (size)  
 (5) screen 10' 215'  
 (length) (depth to top)  
 2" PVC  
 (size) (material)  
 (6) pump 2 15  
 (HP) (yield gpm)  
 Electric  
 (type power)  
 (7) electric log NO  
 (yes or no)  
 NO  
 (organization running log)  
 (8) how well bottom plugged sand seal

description of formations encountered	from	to
Red clay	0	7
Red sand clay	7	21
Red loam clay	21	43
Blue clay	43	170
Sand & gravel	170	225


**CODED**

DEPT. OF NATURAL RESOURCES  
 BUREAU OF LAND & WATER RESOURCES  
**RECEIVED**  
 OCT 20 1981

DRILLERS REMARKS:

If well telescopes please sketch and show depths.

GROUND LEVEL

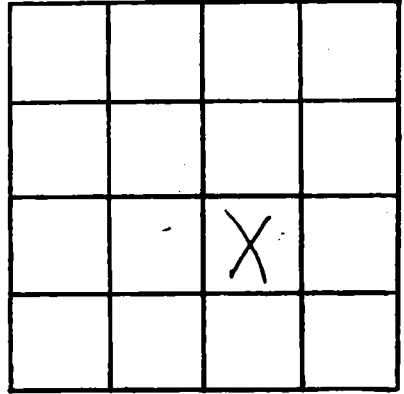

SECTION 22

Please indicate well location X.

ADDITIONAL INFORMATION

If more than one screen, show locations of each on sketch.