

MISSISSIPPI DEPARTMENT OF NATURAL RESOURCES

Bureau of Land and Water Resources

Southport Mall

P.O. Box 10631

Jackson, Mississippi 39209

CODED

COASTAL DRILLING & SERVICE CO.
WELL DRILLERS LOG

ROUTE 1 BOX 618

BILOXI, MISS. *Harrison*
firm name

Harrison
county well located

Harrison
F271

11/18/81 19
date well completed

LANDOWNER: *Rich Dombine*

description of formations encountered

from to

Moraine cl
Sp. m. s.
(mailing address)

<i>top soil</i>	1	2
<i>Red Clay</i>	2	15
<i>S. Blue Clay</i>	15	42
<i>Sp. s.</i>	42	60
<i>Coar. white sand</i>	60	80

WELL LOCATION:

sec. 21 T. 6 N. R. 12 E
S W
(U.S. Gov.) miles West of Jayman
(distance) (direction) (nearest town)

WELL PURPOSE: *home*
(home, irrigation, municipal, industrial)

WELL COMPLETION DATA:

- (1) diameter (inches) 2"
- (2) total depth (feet) 80'
- (3) static water level (feet) 10' below top of ground
- (4) casing pk, 70'
(material) (depth)
(size) if telescope see back.
- (5) screen 10', 70'
(length) (depth to top)
2", pk
(size) (material)
- (6) pump one, 15
(HP) (yield gpm)
ele
(type power)
- (7) electric log no
(yes or no)
(organization running log)

(8) how well bottom plugged?
2" back wash / clean
DRILLERS REMARKS *5' or 5'*

CODED


DEPT. OF NATURAL RESOURCES
BUREAU OF LAND & WATER RESOURCES

FEB 15 1982

RECEIVED

If well telescopes please sketch and show depths.

GROUND LEVEL

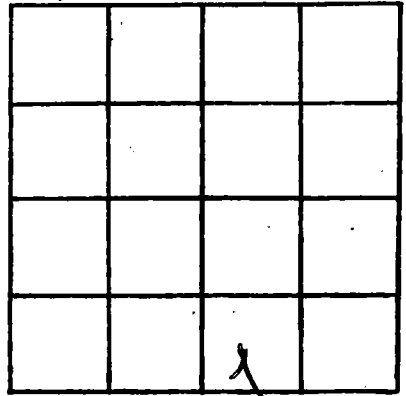

SECTION _____

Please indicate well location X.

ADDITIONAL INFORMATION

If more than one screen, show locations of each on sketch.