

MISSISSIPPI DEPARTMENT OF NATURAL RESOURCES

Bureau of Land and Water Resources

Southport Mall

P.O. Box 10631

CODED

Jackson, Mississippi 39209

WATER WELL DRILLERS LOG

Harrison
F272

2/17 1982 Lyman Well Co. Harrison
date well completed firm name county well located

LANDOWNER: Gary Deeterman
Rt. 3 Gulfport, MS
Russell Road 39503
Lyman Miss.
(mailing address)

description of formations encountered	from	to
<u>Red Sand</u>	<u>0</u>	<u>40</u>
<u>Grey Clay</u>	<u>40</u>	<u>129</u>
<u>Blue Clay</u>	<u>129</u>	<u>200</u>
<u>Good Sand</u>	<u>200</u>	<u>257</u>

WELL LOCATION:
sec. 22 T. 6 N. R. 12 E.
1 miles N/W of Lyman
(distance) (direction) (nearest town)

CODED

WELL PURPOSE: Home
(home, irrigation, municipal, industrial)

- WELL COMPLETION DATA:
- (1) diameter (inches) 2
 - (2) total depth (feet) 257
 - (3) static water level (feet) 60 below above top of ground.
 - (4) casing PVC, 247'
(material) (depth)
2"
(size) if telescope see back.
 - (5) screen 10', 257
(length) (depth to top)
2", PVC
(size) (material)
 - (6) pump N/A, N/A
(HP) (yield gpm)
N/A
(type-power)
 - (7) electric log N/A
(yes or no)
N/A
(organization running log) Sand Shark
 - (8) how well bottom plugged


DEPT. OF NATURAL RESOURCES
BUREAU OF LAND AND WATER RESOURCES
JACKSON, MISSISSIPPI 39209

APR 27 1982

DRILLERS REMARKS:

If well telescopes please sketch and show depths.

GROUND LEVEL

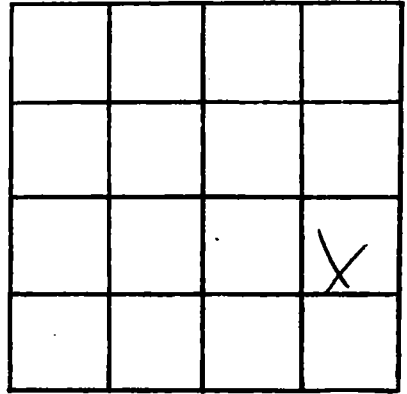

SECTION 22

Please indicate well location X.

ADDITIONAL INFORMATION

If more than one screen,
show locations of each on sketch.