

MISSISSIPPI DEPARTMENT OF NATURAL RESOURCES

Bureau of Land and Water Resources

Southport Mall

P.O. Box 10631

Jackson, Mississippi 39209

CODED

WATER WELL DRILLERS LOG

Davis
F273

2/18 1982 Lyman Well Co. HARRISON Cty.
date well completed firm name county well located

LANDOWNER: Mr. Wild
Rt. 3 Gpt. MS
Russell Road 39503
Lyman MS.
(mailing address)

| description of formations encountered | from | to |
|---------------------------------------|------|-----|
| Red Sand & gravel | 0 | 80 |
| Blue Clay | 80 | 130 |
| Fine Sand | 130 | 158 |
| Fine Sand Blue Clay | 158 | 315 |
| good Sand | 315 | 409 |

WELL LOCATION:
sec. 22 T 6 N R 11 E
4 miles NW of Lyman
(distance) (direction) (nearest town)

CODED

WELL PURPOSE: Home
(home, irrigation, municipal, industrial)

- WELL COMPLETION DATA:
- (1) diameter (inches) 2"
 - (2) total depth (feet) 409
 - (3) static water level (feet) 30 below top of ground.
 - (4) casing 2" 399
(material) (depth)
 - 2" If telescope see back.
(size)
 - (5) screen 10' 409
(length) (depth to top)
 - 2" PVC
(size) (material)
 - (6) pump 1 15
(HP) (yield gpm)
 - Elect.
(type power)
 - (7) electric log NO
(yes or no)
 - NO
(organization running log) Sand Shark
 - (8) how well bottom plugged Sand Shark

DEPT. OF NATURAL RESOURCES
BUREAU OF LAND & WATER RESOURCES


APR 23 1982

RECEIVED

DRILLERS REMARKS:

If well telescopes please sketch and show depths.

GROUND LEVEL

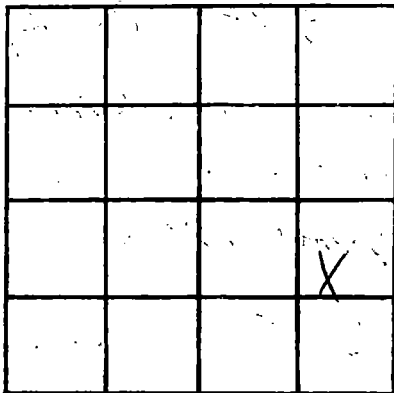

SECTION 22

Please indicate well location X.

ADDITIONAL INFORMATION

If more than one screen, show locations of each on sketch.