

MISSISSIPPI DEPARTMENT OF NATURAL RESOURCES

Bureau of Land and Water Resources

Southport Mall

P.O. Box 10631

**CODED**

Jackson, Mississippi 39209

WATER WELL DRILLERS LOG

Harrison  
F276

6/22 1982 Lyman Well Co. Harrison Cnty.  
date well completed firm name county well located

LANDOWNER: MR Guillory  
820 Leich Rd  
Apt, Md 39501  
(mailing address)

description of formations encountered	from	to
Red Clay Sand	0	100
Gravel		
Gumbo Clay	100	240
Five Sand	240	263
Blue Clay	263	320
Blue Clay Five Sand	320	483
Blue Clay	483	500
Medium Sand	500	559

WELL LOCATION:  
sec 27 T 6 N R 12 E  
6 miles W of Lyman  
(distance) (direction) (nearest town)

WELL PURPOSE: Home  
(home, irrigation, municipal, industrial)

WELL COMPLETION DATA:  
(1) diameter (inches) 2"  
(2) total depth (feet) 559  
(3) static water level (feet) 95' below above top of ground.  
(4) casing PVC, 549,  
(material) (depth)  
2"  
(size) if telescope see back.  
(5) screen 10', 559  
(length) (depth to top)  
2", PVC  
(size) (material)  
(6) pump 1/2, 9  
(HP) (yield gpm)  
Elec.  
(type power)  
(7) electric log NO  
(yes or no)  
NO  
(organization running log) Sand Shark  
(8) how well bottom plugged

**CODED**

DEPT. OF NATURAL RESOURCES  
BUREAU OF LAND & WATER RESOURCES


JUL 20 1982

**RECEIVED**

DRILLERS REMARKS:

If well telescopes please sketch and show depths.

GROUND LEVEL

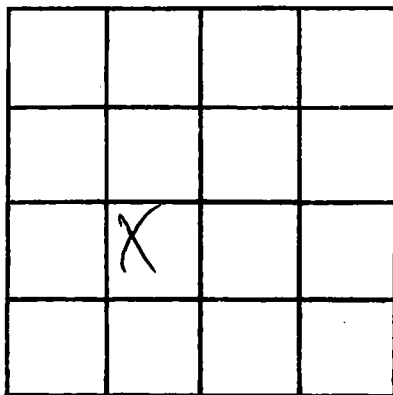

SECTION 07

Please indicate well location X.

ADDITIONAL INFORMATION

If more than one screen, show locations of each on sketch.