

MISSISSIPPI DEPARTMENT OF NATURAL RESOURCES

Bureau of Land and Water Resources

Southport Mall

P.O. Box 10631

**CODED**

Jackson, Mississippi 39209

**WATER WELL DRILLERS LOG**  
**COASTAL DRILLING & SERVICE CO.**

ROUTE 1 BOX 618

BILOXI MISS. 39532

county well located

Harrison  
F277

6/2/82 19\_\_  
 date well completed

Harrison  
 county well located

LANDOWNER: Joe Kisse  
Big Hill Road  
Spit Ms  
 (mailing address)

description of formations encountered	from	to
top soil	1	3
red clay	3	20
signal sand	20	35
plum clay	35	40
yellow sand	40	65
light blue clay	65	210
hard blue clay	210	300
good water sand	300	320

WELL LOCATION:  
 sec 20 T 6 S R 12 E  
1/4 of 1/4  
1/4 sec (distance) (direction) of (nearest town)

WELL PURPOSE: home  
 (home, irrigation, municipal, industrial)

**CODED**

WELL COMPLETION DATA:

- (1) diameter (inches) 2"
- (2) total depth (feet) 320'
- (3) static water level (feet) 85' below above top of ground.
- (4) casing PVC 310'  
 (material) (depth)  
 (size) if telescope see back.
- (5) screen 10' 310'  
 (length) (depth to top)  
2" PVC  
 (size) (material)
- (6) pump 1/2 13  
 (HP) (yield gpm)  
ell  
 (type power)
- (7) electric log no  
 (yes or no)

(organization running log)

(8) how well bottom plugged  
2" back of steel valve  
 DRILLERS REMARKS: HB


DEPT. OF NATURAL RESOURCES  
 BUREAU OF LAND & WATER RESOURCES

NOV 30 1982

**RECEIVED**

If well telescopes please sketch and show depths.

GROUND LEVEL

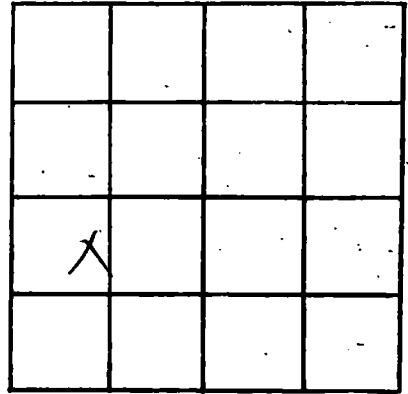

SECTION \_\_\_\_\_

Please indicate well location X.

ADDITIONAL INFORMATION

A series of horizontal lines for writing additional information.

If more than one screen, show locations of each on sketch.