

MISSISSIPPI DEPARTMENT OF NATURAL RESOURCES

Bureau of Land and Water Resources

Southport Mall

P.O. Box 10631

Jackson, Mississippi 39209

WATER WELL DRILLERS LOG

CODED

Harrison
F279

Sept. 2 1982 Duncan Well Drilling Harrison
date well completed firm name county well located

LANDOWNER: Melton Cox
1013 Shirley Drive
Southport, Ms.
(mailing address)

description of formations encountered	from	to
<u>Mud & Sand</u>	<u>0</u>	<u>30</u>
<u>Blue Clay</u>	<u>30</u>	<u>250</u>
<u>fine Sand</u>	<u>250</u>	<u>358</u>
<u>Course Sand</u>	<u>358</u>	<u>420</u>

WELL LOCATION:
sec 10 T 6 N 5 R 12 E W
5 miles W of Osman
(distance) (direction) (nearest town)

CODED

WELL PURPOSE: Home
(home, irrigation, municipal, industrial)

WELL COMPLETION DATA:
(1) diameter (inches) 2"
(2) total depth (feet) 480 ft.
(3) static water level (feet) 80' below above top of ground.
(4) casing PVC 410
(material) (depth)
(size) if telescope see back.
(5) screen 10' 410
(length) (depth to top)
2" PVC
(size) (material)
(6) pump _____ (HP) _____ (yield gpm)
(type power)
(7) electric log _____ (yes or no)
(organization running log)
(8) how well bottom plugged hand

DEPT. OF NATURAL RESOURCES
BUREAU OF LAND & WATER RESOURCES


JAN 21 1983

DRILLERS REMARKS: owner
installed Air
Own pump

RECEIVED

If well telescopes please sketch and show depths.

GROUND LEVEL

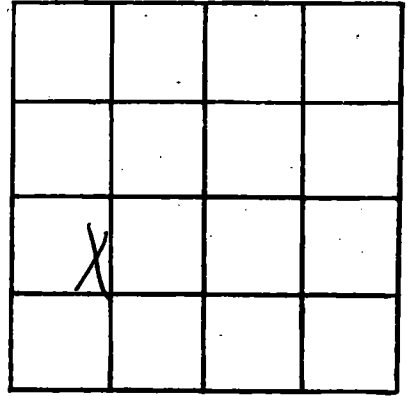

SECTION 10

Please indicate well location X:

ADDITIONAL INFORMATION

If more than one screen, show locations of each on sketch.