

MISSISSIPPI DEPARTMENT OF NATURAL RESOURCES

Bureau of Land and Water Resources

Southport Mall

P.O. Box 10631

CODED

Jackson, Mississippi 39209

WATER WELL DRILLERS LOG

Harrison  
F280

7/23/82 date well completed 82 Lyman Well Co. firm name Harrison county well located

LANDOWNER: Ray Wormley  
Rt. 3, Box 604  
Sgt, Md 39503  
(mailing address)

description of formations encountered	from	to
Red Clay & Sand & Gravel	0	100
Clumbo Clay	100	180
Run powder Sand	180	230
Blue Clay	230	290
Medium Good Sand	290	387

WELL LOCATION:  
sec 24 T 6 N R 12 E  
12 miles (distance) N/W (direction) of Got. (nearest town)

WELL PURPOSE: Home  
(home, Irrigation, municipal, Industrial)

CODED

- WELL COMPLETION DATA:
- (1) diameter (inches) 4x2
  - (2) total depth (feet) 387
  - (3) static water level (feet) 80 <sup>below</sup> <sub>above</sub> top of ground.
  - (4) casing PVC 367  
(material) (depth)
  - 4x2 (size) If telescope see back.
  - (5) screen 20' 387  
(length) (depth to top)
  - 2" PVC  
(size) (material)
  - (6) pump 1/2 34  
(HP) (yield gpm)
  - Elect  
(type power)
  - (7) electric log NO  
(yes or no)
  - NO  
(organization running log)
  - (8) how well bottom plugged Sand  
Shank

DEPT. OF NATURAL RESOURCES  
BUREAU OF LAND & WATER RESOURCES

FEB 25 1983

RECEIVED

DRILLERS REMARKS:


If well telescopes please sketch and show depths.

GROUND LEVEL

200  
4"

160'  
2"

20'  
2"  
SCREEN

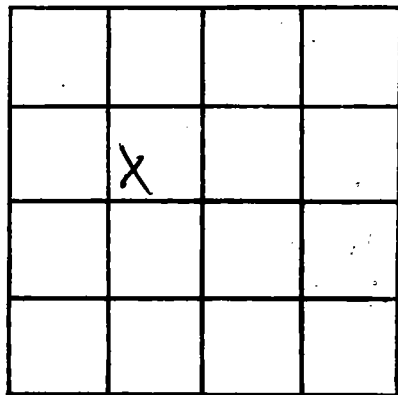

SECTION 24

Please indicate well location X.

ADDITIONAL INFORMATION

If more than one screen,  
show locations of each on sketch.