

MISSISSIPPI DEPARTMENT OF NATURAL RESOURCES

Bureau of Land and Water Resources

Southport Mall

P.O. Box 10631

Jackson, Mississippi 39209

WATER WELL DRILLERS LOG

CODED

F 283  
 HARRISON  
 7-30-83

7/30/83 date well completed  
 Lyman Well Co. firm name  
 Harrison county well located

LANDOWNER: Lee Dubose  
Lot 66 Windy Hills  
apt 39503  
 (mailing address)

description of formations encountered	depth	
	from	to
Red clay	0	20
sand	20	60
clay	60	120
Good sand	120	152

WELL LOCATION:  
 sec. 13 T. 6 N. R. 12 E. S. 2 W.  
16 miles (distance) N (direction) Lory Beach (nearest town)

WELL PURPOSE: home  
 (home, irrigation, municipal, industrial)

WELL COMPLETION DATA:

(1) diameter (inches) 2"

(2) total depth (feet) 152'

(3) static water level (feet) 60  below  above top of ground.

(4) casing PVC (material), 142' (depth)  
2" (size) if telescope see back.

(5) screen 10' (length), 142' (depth to top)  
2" (size), PVC (material)

(6) pump 1 (HP), 12 (yield gpm)  
electric (type power)

(7) electric log No (yes or no)  
No (organization running log)

(8) how well bottom plugged sand shark

DEPT. OF NATURAL RESOURCES  
 BUREAU OF LAND & WATER RESOURCES


APR 30 1984

RECEIVED

DRILLERS REMARKS: \_\_\_\_\_

If well telescopes please sketch and show depths.

GROUND LEVEL

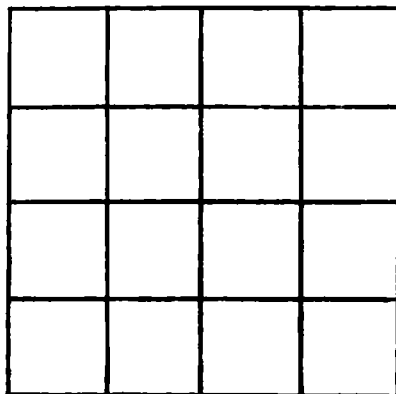

SECTION \_\_\_\_\_

Please indicate well location X.

ADDITIONAL INFORMATION

If more than one screen, show locations of each on sketch.